

Castleton Zoning Administrator

From: Shawn Cunningham <scunningham@olearyburke.com>
Sent: Tuesday, June 7, 2022 12:30 PM
To: Bryan Currier; Castleton Zoning Administrator
Cc: Zak Hale; Brad Dousevicz
Subject: RE: Plan sheet changes

Hi Jonas,

See below:

Sheet 1: No changes unique to only this sheet, but shows updated landscaping, parking islands, and EV charging station
Sheet 2: Same as Sheet 1, and also shows enlarged stormwater area to treat 15-year storm event
Sheet 3: Reconfigured catch basin network and enlarged stormwater area
Sheet 4: Reconfigured catch basin network and enlarged stormwater area, updated calculations and outlet structure inverts
Sheet 5: No changes
Sheet 7: No changes besides showing updated landscaping
Sheet 8: No changes
Sheet 9: Added dumpster enclosure detail
Sheet L1.0 Landscaping: Revised to add more trees in open area between parking lot and road, added trees in new parking lot islands, landscaped southern property line, added cleaner planting schedule as well as a PDF of the planting schedule


Thank you,

Shawn Cunningham, E.I.
O'Leary-Burke Civil Associates
13 Corporate Drive | Essex Jct., VT 05452
p: (802)878-9990
scunningham@olearyburke.com

From: Bryan Currier <bcurrier@olearyburke.com>
Sent: Tuesday, June 7, 2022 11:56 AM
To: Castleton Zoning Administrator <zoning@castletonvt.org>; Shawn Cunningham <scunningham@olearyburke.com>
Cc: Zak Hale <zak@haleresources.com>; Brad Dousevicz <dousevicz@gmail.com>
Subject: RE: Plan sheet changes

Planting Schedule

	Qty.	Code	Scientific Name	Common Name	Size	Spec	Notes
TREES	16	AB	ABIES balsamea	Balsam Fir	5' Ht.	B&B	
	10	ARR	ACER rubrum 'Red Sunset'	Red Sunset Red Maple	2" Cal.	B&B	
	5	AxF	ACER x freemanii 'Autumn Blaze'	Autumn Blaze Maple	8' Ht.	B&B	Clump Form
	10	BNH	BETULA nigra 'Heritage'	Heritage River Birch	10' Ht.	B&B	multi-stemmed
	5	BPS	BETULA papyrifera 'Select'	Paper Birch	8' Ht.	B&B	Clump Form
	6	CO	CELTIS occidentalis	Common Hackberry	2" Cal.	B&B	
	7	CCI	CRATAEGUS crusgalli inermis	Thornless Cockspur Hawthorn	8' Ht.	B&B	Clump Form
	8	GTH	GLEDITSIA t.i. 'Halka'	Halka Honeylocust	2" Cal.	B&B	
	6	HV	HAMAMELIS virginiana	Common Witchhazel	4' Ht.	B&B	multi-stemmed
	2	MLA	MAGNOLIA liliiflora 'ann'	Ann Magnolia	6-6' Ht.	B&B	multi-stemmed
	21	PG	PICEA glauca	White Spruce	5' Ht.	B&B	
	22	PS	PINUS strobus	White Pine	5' Ht.	B&B	
	5	PSA	PRUNUS sargentii	Sargent Cherry	2" cal.	B&B	
	9	QM	QUERCUS macrocarpa	Burr Oak	2" Cal.	B&B	
	1	SR	SYRINGA reticulata 'Ivory Silk'	Japanese Tree Lilac	1.5" Cal.	B&B	
	5	TO	THUJA occidentalis 'Nigra'	Dark American Arborvitae	5' Ht.	B&B	
	6	TC	TILIA cordata 'Greenspire'	Greenspire Linden	1.5" Cal.	B&B	
	SHRUBS	11	AN	AZALEA 'Northern Hi-Lights'	Northern Hi-Lights Azalea	24" Ht.	#3 Cont.
13		CSF	CORNUS sericea 'Firedance'	Firedance Red-Osier Dogwood	2' Ht.	#5 Cont.	
23		HPB	HYDRANGEA paniculata 'Bobo'	Bobo Panicle Hydrangea	18" Ht.	#2 Cont.	
10		HPS	HYDRANGEA paniculata 'Sweet Summer'	Sweet Summer Hydrangea	30" Ht.	B&B	
15		JCM	JUNIPERUS chinensis 'Mint Julep'	Mint Julep Juniper	24" Ht.	#3 Cont.	
10		JCS	JUNIPERUS chinensis 'Sea Green'	Sea Green Juniper	30"	B&B	
14		PF	POTENTILLA fruticosa 'Pink Beauty'	Pink Beauty Potentilla	18" Ht.	#3 Cont.	
13		SA	SPIRAEA albilifera	White Spirea	18"	#3 Cont.	
23		SJ	SPIRAEA japonica 'Little Princess'	Spirea	18"	#3 Cont.	
2		SPJ	Syringa prestoniae 'James MacFarlane'	James MacFarlane Lilac	36" Ht.	#5 Cont.	
PERENNIALS	18	TMD	TAXUS media 'Densiflora'	Dense Yew	18" Ht.	B&B	
	18	AG	ANDROPOGON gerardii 'Red October'	Red October Big Bluestem	Clump	#2 Cont.	
	9	ACP	ASTILBE chinensis 'Pumila'	Pumila Astilbe	Clump	#1 Cont.	
	24	AF	ATHYRIUM f.f. 'Lady in Red'	Northern Lady Fern	Clump	#1 Cont.	
	18	CB	CALAMAGROSTIS brachytricha	Korean Feather Reed Grass	Clump	#1 Cont.	
	25	CK	CALAMAGROSTIS 'Karl Foerster'	Feather Reed Grass	Clump	#1 Cont.	
	20	EPR	ECHINACEA p. 'Rainbow Marcella'	Rainbow Marcella Echinacea	Clump	#2 Cont.	
	27	HHR	HEMEROCALLIS 'Rosy Returns'	Rosy Returns Daylily	Clump	#2 Cont.	30" O.C.
	14	HSO	HEMEROCALLIS 'Stella Odorata'	Rosy Returns Daylily	Clump	#2 Cont.	30" O.C.
	62	RAG	RHUS aromatica 'Gro-Jow'	Gro-low Fragrant Sumac	18" Ht.	#3 Cont.	
12	RFG	RUDBECKIA fulgida var. s. 'Goldsturm'	Black Eye Susan	Clump	#2 Cont.		

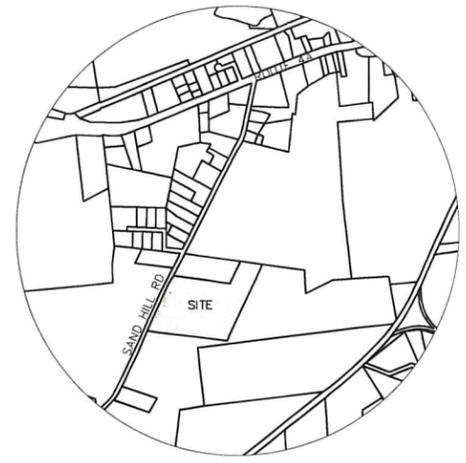


Location Map
Scale: 1" = 100'

*Landscaping
2 Parking Islands
15-YR
34 stems*

ZONING SUMMARY	
PROPERTY INFORMATION:	ADDRESS: 0 SAND HILL ROAD SPAN #: 1 29-040-1 04 09 PARCEL ID #: 0901 0001 1
ZONING DISTRICT:	RURAL RESIDENTIAL 2 ACRE
FRONT/REAR SETBACK:	50 FEET
SIDE YARD SETBACK:	30 FEET

OWNER
TOWN OF CASTLETON
PO BOX 727
CASTLETON, VT

APPLICANT
DOUSEVICZ, INC.
21 CARMICHAEL STREET
ESSEX JUNCTION, VT

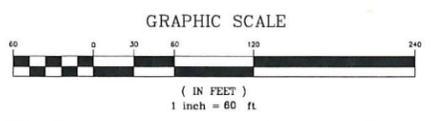

DATE	REVISION	BY	SEC
03/21/08	RECORD DRAWING		
03/21/08	PRELIMINARY		
03/21/08	SKETCH/CONCEPT		
03/21/08	DESIGN		
03/21/08	DRAWING		
03/21/08	CHECKED		
03/21/08	SCALE		


**O'LEARY-BURKE
CIVIL ASSOCIATES, PLC**

13 CORPORATE DRIVE
ESSEX JUNCTION, VT
PHONE: 878-9989
FAX: 878-9989
E-MAIL: o'b@olearyburke.com

Senior Living Facility
Sand Hill Road

Overall Parcel Plan

DATE: 04-08-20
BY: JCB
SCALE: 1" = 60'
PLAN SHEET #
1

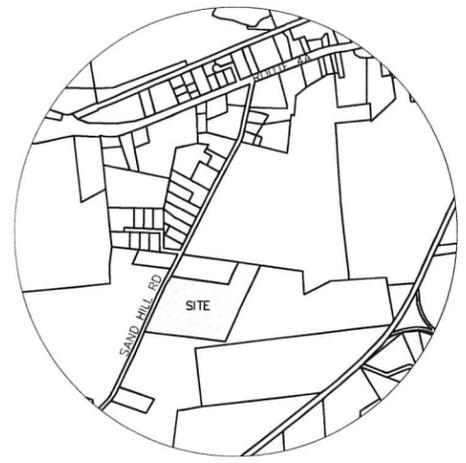

Location Map
Scale: 1" = 1000'

Legend

	PROJECT BOUNDARY
	EXISTING OUTLOT LINE
	PROPOSED PROPERTY LINE
	SETBACK
	SIDELINE OF EASEMENT
	CONTOUR LINE (U.S.G.S. DATUM)
	PROPOSED FINISH GRADE CONTOUR
	EDGE OF WOODED AREA
	PROPOSED CLEARING LIMITS
	EXISTING SEWERLINE
	PROPOSED SEWER SERVICE
	PROPOSED SEWER FORCE MAIN
	EXISTING WATERLINE
	PROPOSED WATER SERVICE
	PROPOSED STORMWATER
	EXISTING ELECTRIC
	PROPOSED ELECTRIC SERVICE
	EXISTING/PROPOSED HYDRANT
	PROPOSED LIGHTS
	PROPOSED RETAINING WALL
	PROPOSED FENCE


ROBERT & MARY HARRIS
LIFE ESTATE
N/F

ZONING SUMMARY

PROPERTY INFORMATION:	ADDRESS: 0 SAND HILL ROAD SPAN #: 129-040-10409 PARCEL ID #: 090100011
ZONING DISTRICT:	RURAL RESIDENTIAL 2 ACRE
FRONT/REAR SETBACK:	50 FEET
SIDE YARD SETBACK:	30 FEET

OWNER
TOWN OF CASTLETON
PO BOX 727
CASTLETON, VT

APPLICANT
DOUSEVICZ, INC.
21 CARMICHAEL STREET
ESSEX JUNCTION, VT

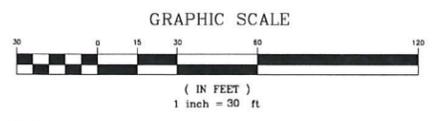

DATE: 6-1-22	REVISION: 4/15/23 PER TOWN COMMENTS	BY: SEC
SURVEY: OBCA	RECORD DRAWING	DATE: 04-08-22
DESIGN: SFC/BWC	PRELIMINARY	DATE: 12-01-21
DRAWN: SEC/BWC	SKETCH/CONCEPT	DATE: 02-21-22
CHECKED: PLD		DATE: 02-21-22
SCALE: 1" = 30'		DATE: 02-21-22

O'LEARY-BURKE
CIVIL ASSOCIATES, PLC

13 CORPORATE DRIVE
ESSEX JUNCTION, VT
PHONE: 878-9900
FAX: 878-9909
E-MAIL: oburke@olearyburke.com

Senior Living Facility
Sand Hill Road




Castleton Vermont

Site Plan

PLAN SHEET 1
2



Legend

- PROJECT BOUNDARY
- EXISTING OUTLOT LINE
- PROPOSED PROPERTY LINE
- SETBACK
- SIDELINE OF EASEMENT
- CONTOUR LINE (U.S.G.S. DATUM)
- PROPOSED FINISH GRADE CONTOUR
- EDGE OF WOODED AREA
- PROPOSED CLEARING LIMITS
- EXISTING SEWERLINE
- PROPOSED SEWER SERVICE
- PROPOSED SEWER FORCE MAIN
- EXISTING WATERLINE
- PROPOSED WATER SERVICE
- PROPOSED STORMWATER
- EXISTING ELECTRIC
- PROPOSED ELECTRIC SERVICE
- EXISTING/PROPOSED HYDRANT
- PROPOSED LIGHTS
- PROPOSED RETAINING WALL
- PROPOSED FENCE

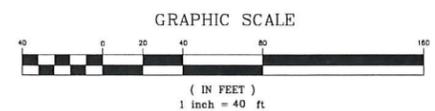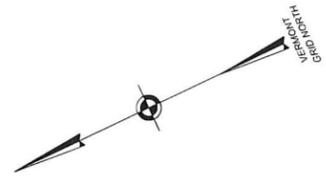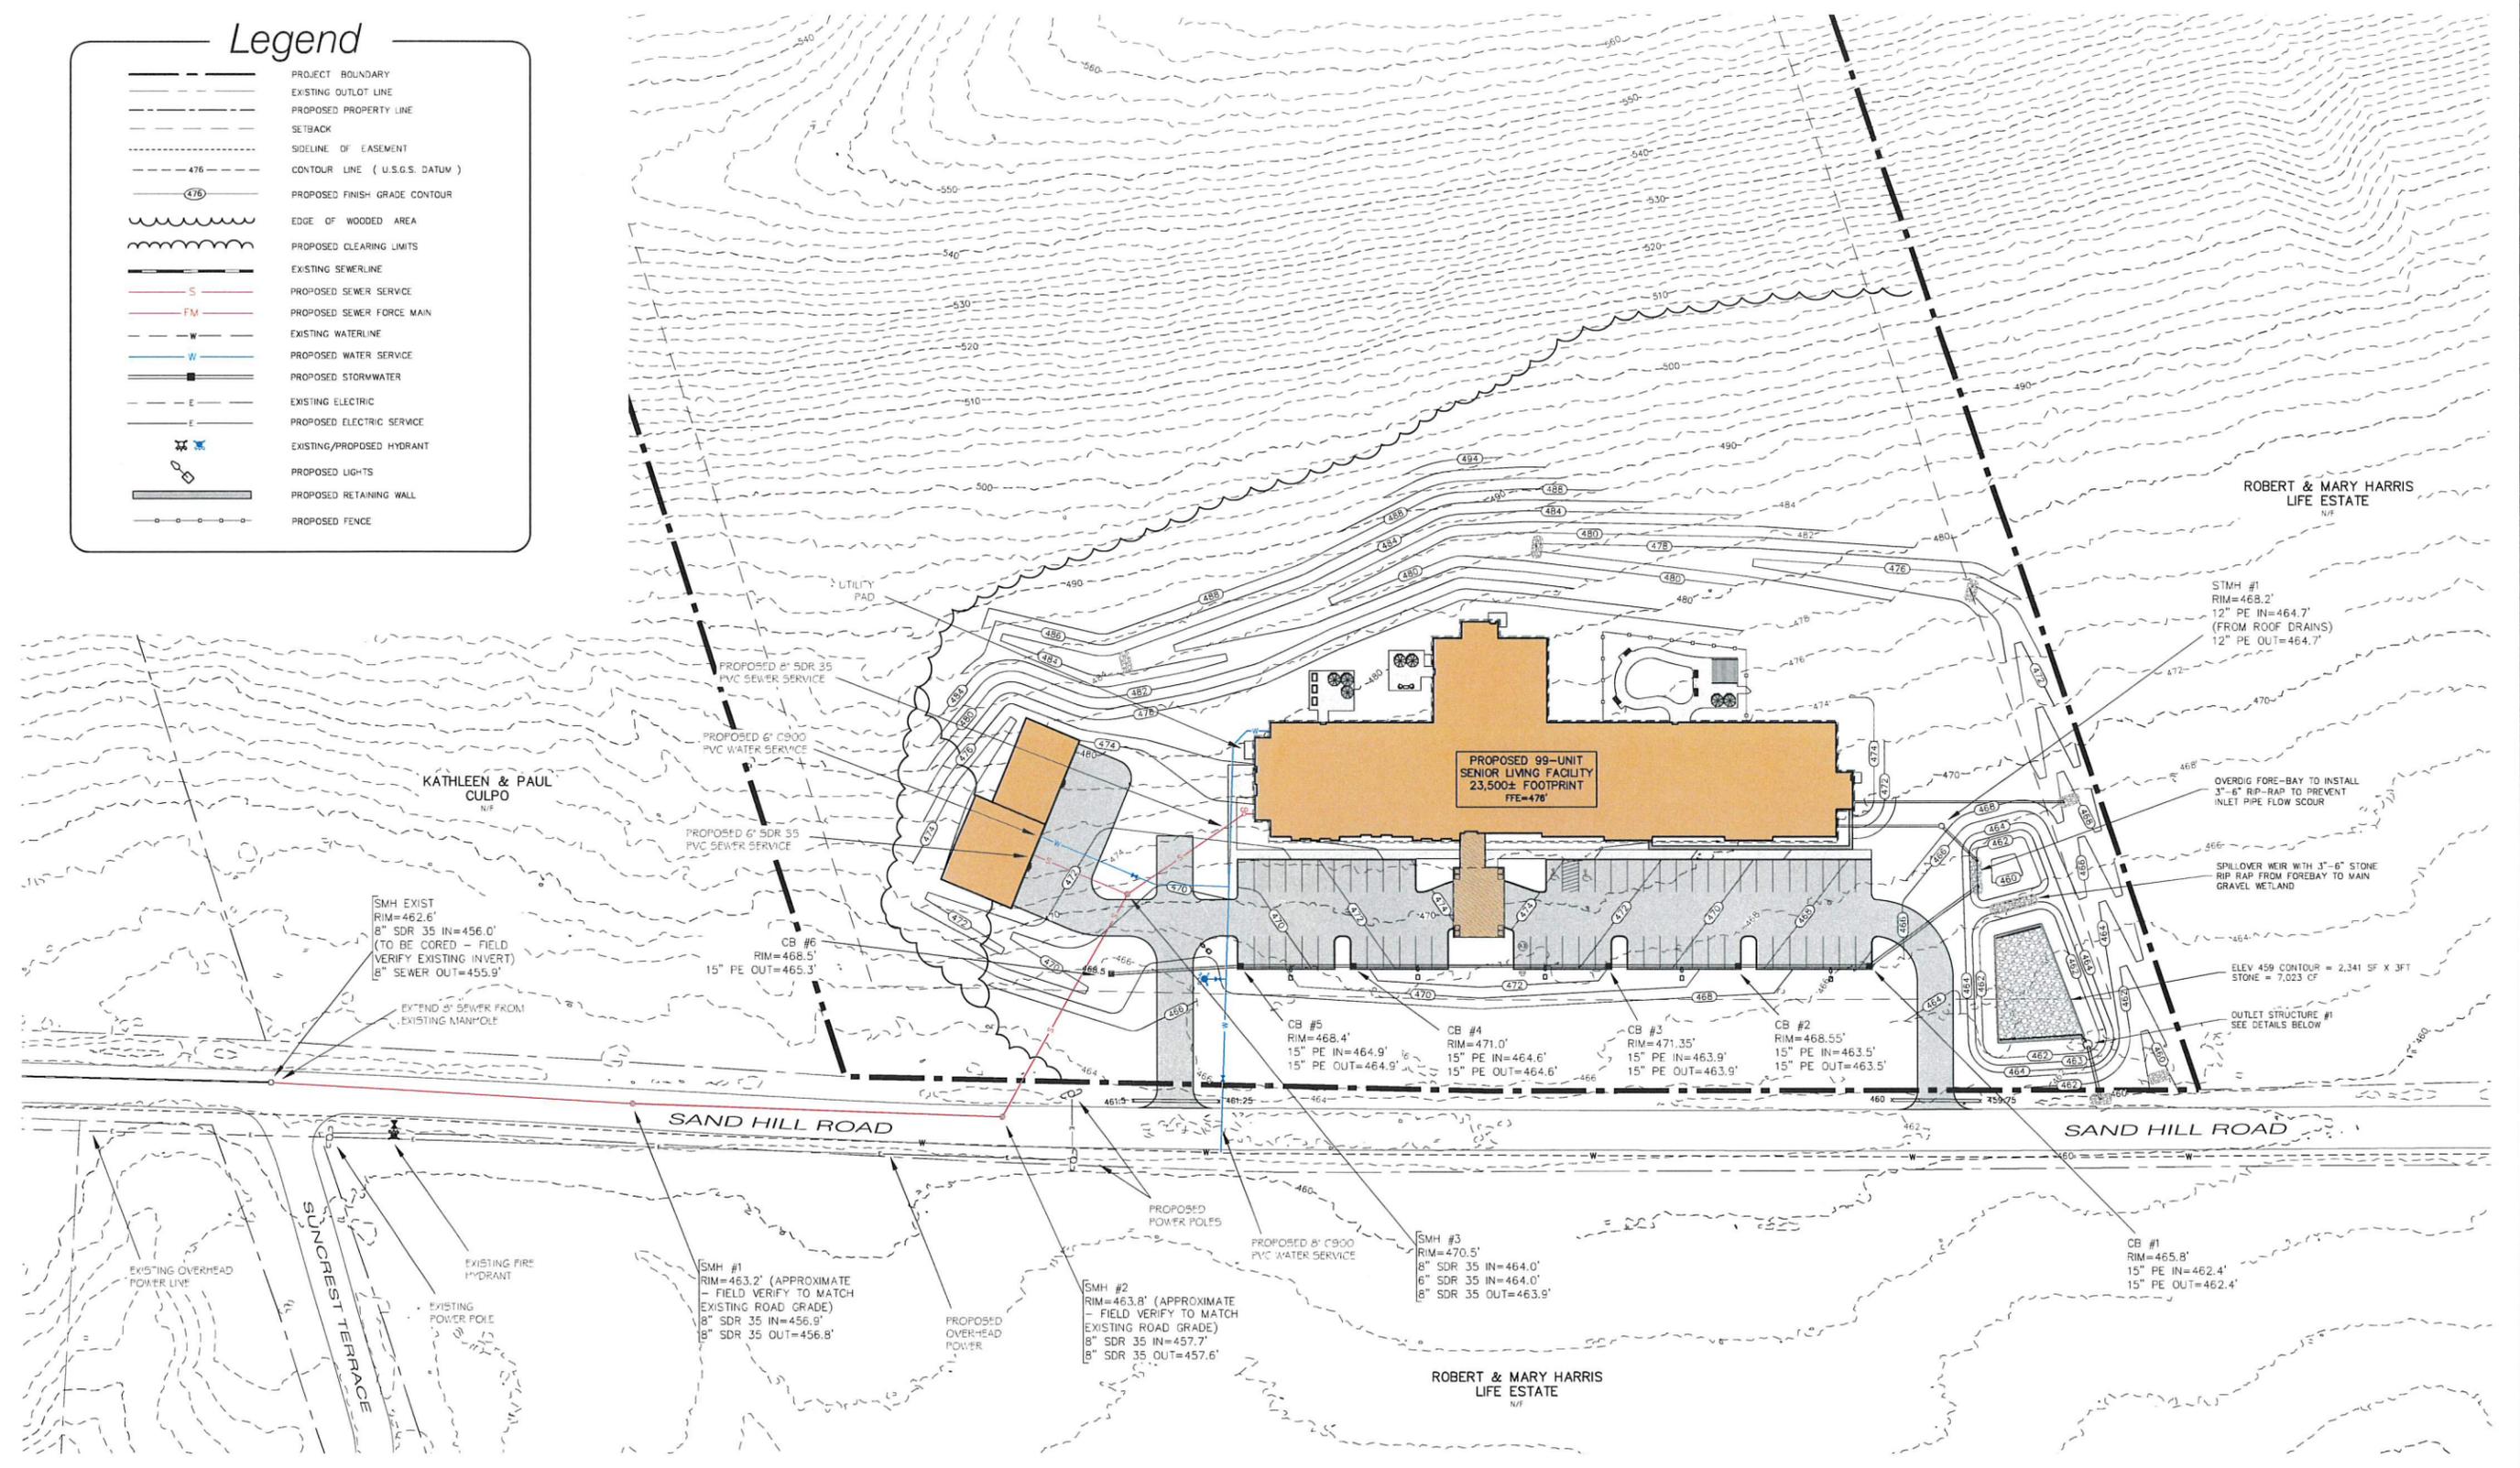

DATE	REVISION	BY	SEC
6-1-22	REVISED PER ICMAN COMMENTS		
SURVEY	OBCA		
DESIGN	SFC/BVC		
DRAWN	SEC/BVC		
CHECKED	RJD		
SCALE	1"=40'		

<input type="checkbox"/> RECORD DRAWING <input checked="" type="checkbox"/> FINAL <input type="checkbox"/> PRELIMINARY <input type="checkbox"/> SKETCH/CONCEPT	Senior Living Facility Sand Hill Road <small>Castleton Vermont</small>	DATE: 04-28-22 JOB#: 2021-08 FILE#: 2021-08-57 PLAN SHEET #
O'LEARY-BURKE CIVIL ASSOCIATES, PLC <small>19 CORPORATE DRIVE ESSEX JCT. VT PH: 802-876-9800 FAX: 876-9868 E-MAIL: o'b@oburkecivil.com</small>	Utilities Plan	3

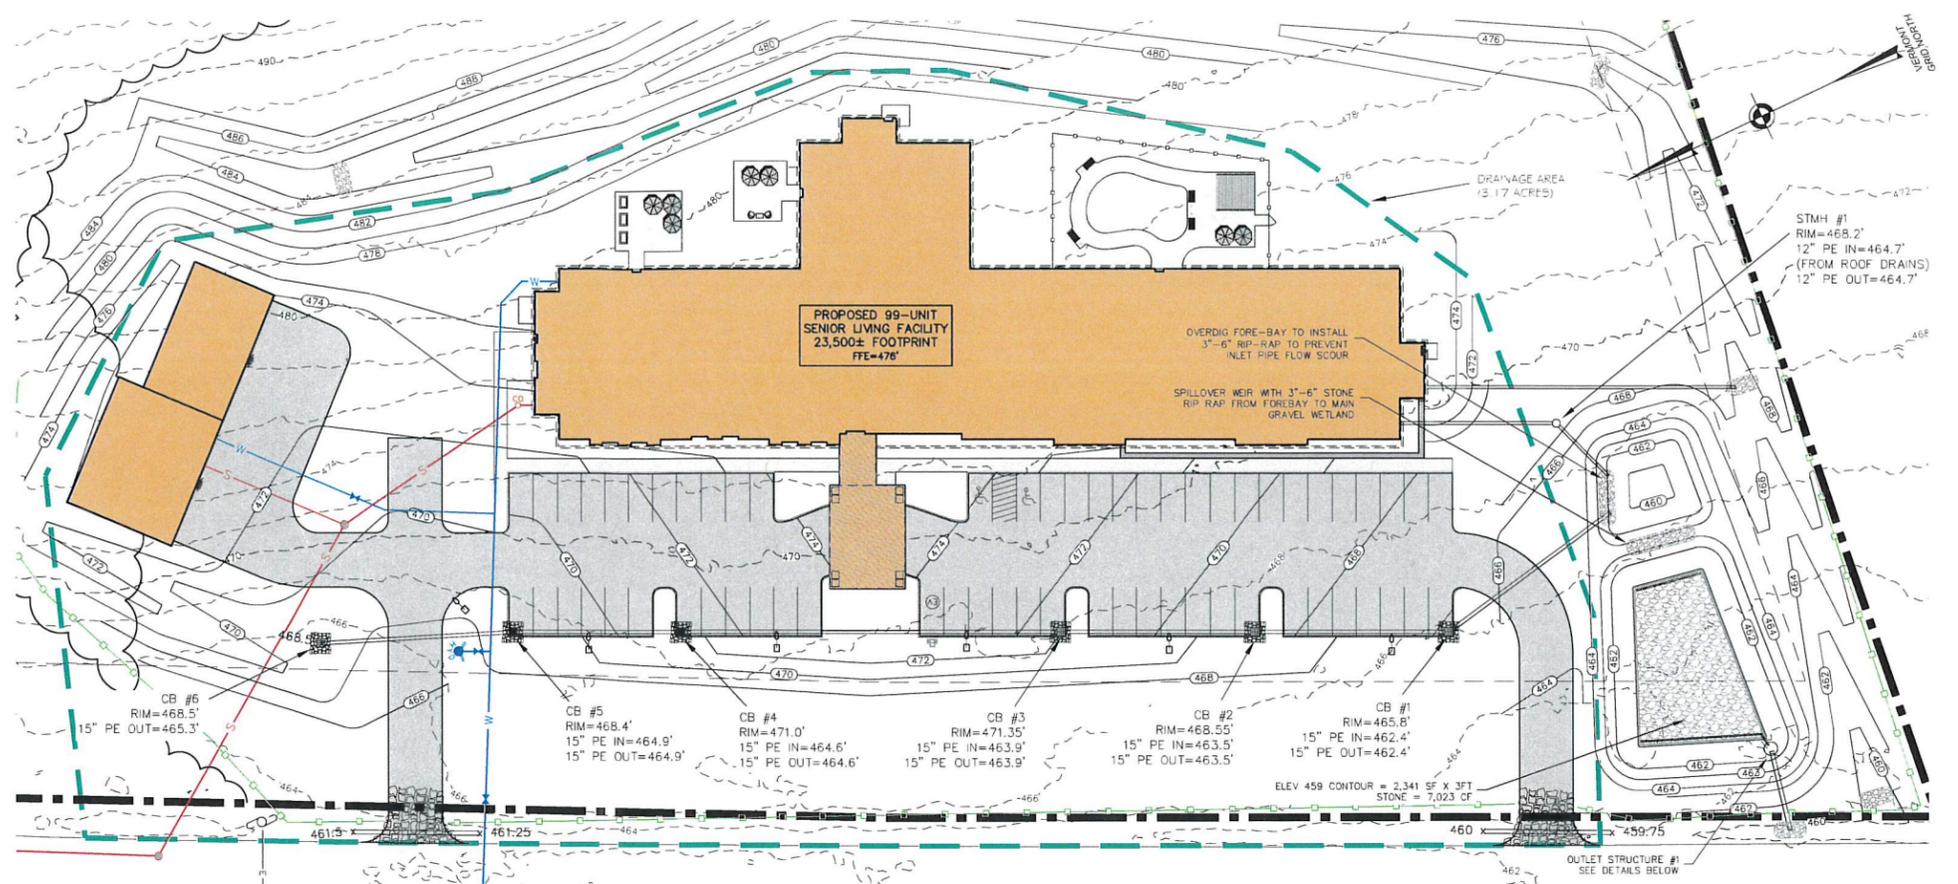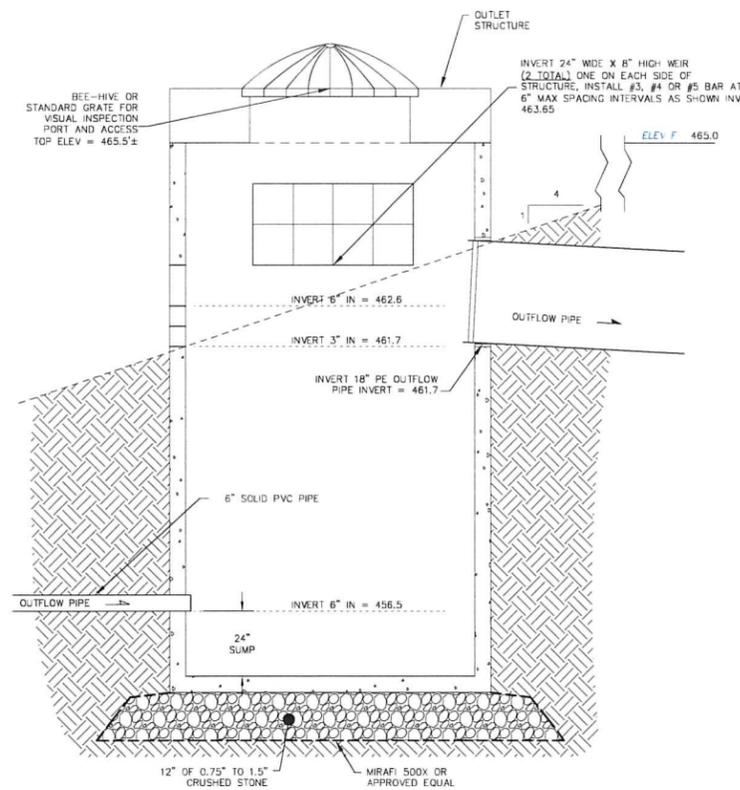


OUTLET CONTROL STRUCTURE

GRAVEL WETLAND SCHEDULE

ITEM	GRAVEL WETLAND SYSTEM #2	DESCRIPTION
NO. CELLS	1	NUMBER OF CELLS
LENGTH	62.5±	LENGTH OF EACH CELL AT BOTTOM
WIDTH	37.5±	WIDTH OF EACH CELL AT BOTTOM
SIDE SLOPES	4H:1V	SIDE SLOPES OF CELLS
GRAVEL THICKNESS	3'	THICKNESS OF GRAVEL
ELEV A	456.0	BOTTOM OF SYSTEM
ELEV B	456.5	6" ABOVE BOTTOM TO OS (OUTLET STRUCTURE)
ELEV C	459.0	TOP OF STONE CONTAINING WATER QUALITY
ELEV D	460.0	BOTTOM OF OPEN BAYS
ELEV E	461.7	100% WOV OR MORE - 1ST OUTLET HOLE
ELEV F	465.0	TOP OF SYSTEM


STORMWATER DESIGN

- DRAINAGE AREA: 3.17 AC.
- IMPERVIOUS: 1.42 AC.
- STATE TREATMENT WETLAND SPREADSHEET
WOV TO PRACTICE = 0.1197 AF = 5,214 CF REQUIRED
STONE PROVIDED = 7,023 CF PROVIDED (SEE ABOVE)
- 10% OF WATER QUALITY VOLUME IN FOREBAY: 5,214 CF X 0.10 = 522 CF
FOREBAY PROVIDED (SEE ABOVE) = 2,265 CF
- SYSTEM SIZED TO PROVIDE FULL WATER QUALITY VOLUME BELOW THE FIRST ORIFICE THROUGH HYDROCAD MODELING
- SYSTEM DESIGNED TO MEET GIVEN BELOW RAINFALL EVENTS FROM NOAA ATLAS 14
-1 YEAR (2.20 IN)
-10 YEAR (3.75 IN)
-15 YEAR (4.05 IN)

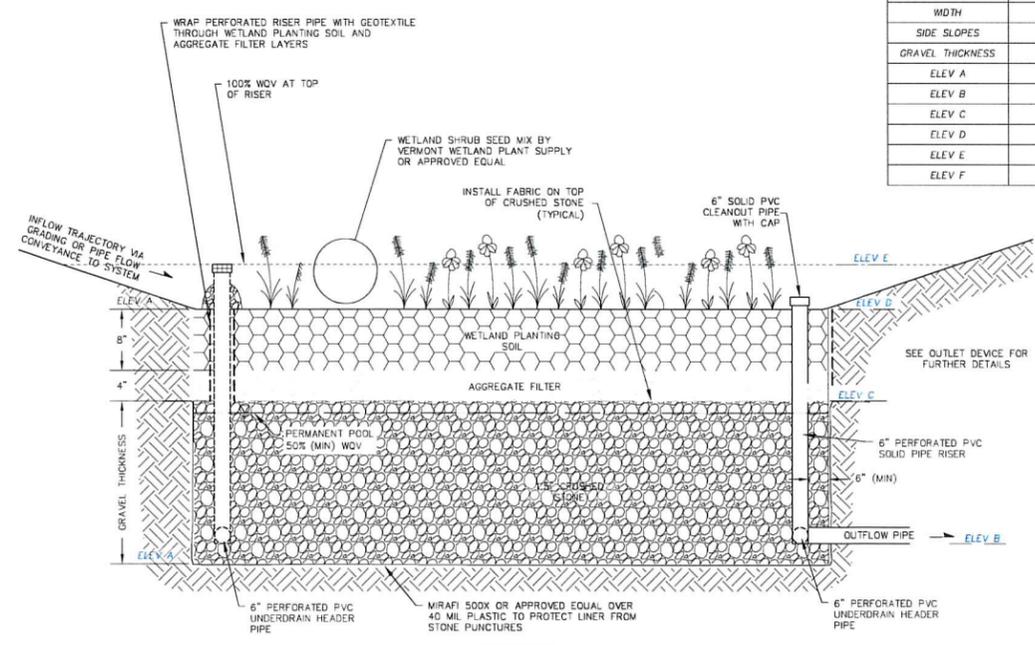


GRAVEL WETLAND DETAIL

NOTE: CONTRACTOR MUST CALL O'LEARY-BURKE FOR INSPECTION OF TREATMENT WETLANDS AND COORDINATE MILESTONES OF INSTALLATION TO ENSURE COMPLIANCE WITH THE PLANS AT 878-9990

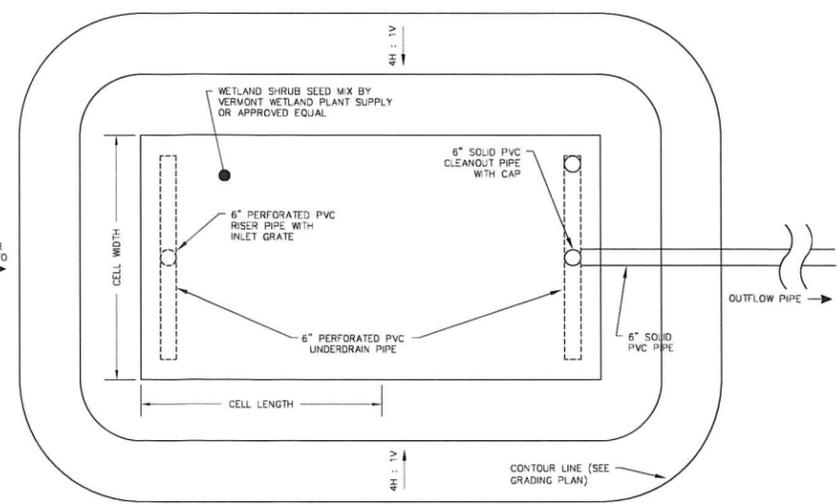

GRAVEL WETLAND DETAIL PLAN

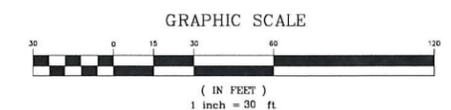

DATE	REVISION	BY	SEC
6-1-22	REVISED PER IDAN COMMENTS		
	<input type="checkbox"/> RECORD DRAWING		
	<input type="checkbox"/> PRELIMINARY		
	<input type="checkbox"/> SKETCH/CONCEPT		
	<input type="checkbox"/> FINAL		


Senior Living Facility
Sand Hill Road

Stormwater Management Plan


O'LEARY-BURKE CIVIL ASSOCIATES, P.L.C.

13 CORPORATE DRIVE
ESSIK CT, VI
P.O. BOX 878-9990
FAIR HAVEN, VT 05743
PHONE: 878-9990
FAX: 878-9990
EMAIL: OLEARY@OLEARY-CIVIL.COM

DATE: 04-28-22
JOB#: 2021-08
FILE: 2021-08-S7
PLAN SHEET # 4


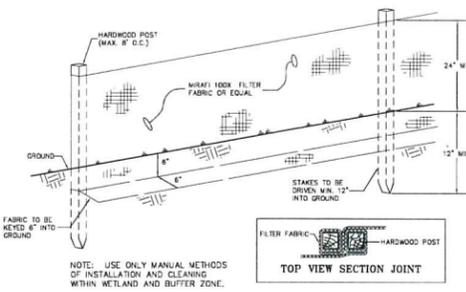


SILT FENCE DETAIL
NTS

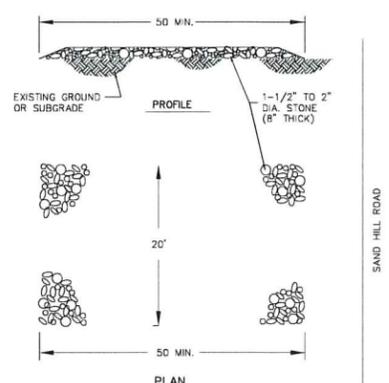

- NOTES:**
1. THE ENTRANCE SHALL BE MAINTAINED IN A CONDITION WHICH WILL PREVENT TRACKING OF SEDIMENT ONTO PUBLIC RIGHTS-OF-WAY. THIS MAY REQUIRE PERIODIC TOP DRESSING WITH ADDITIONAL STONE AS CONDITIONS DEMAND AND REPAIR AND/OR CLEANOUT OF ANY MEASURES USED TO TRAP SEDIMENT. ALL SEDIMENT TRACKED, SPILLED, OR WASHED ONTO PUBLIC RIGHTS-OF-WAY SHALL BE REMOVED IMMEDIATELY BY CONTRACTOR.
 2. THE USE OF CALCIUM CHLORIDE OR WATER MAY BE NECESSARY TO CONTROL DUST DURING THE SUMMER.
 3. PROVIDE APPROPRIATE TRANSITION BETWEEN STABILIZED CONSTRUCTION ENTRANCE AND PUBLIC RIGHT-OF-WAY.

STABILIZED CONSTRUCTION ENTRANCE
NTS

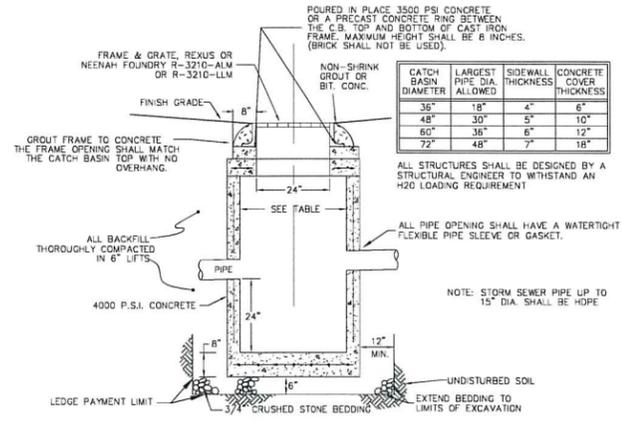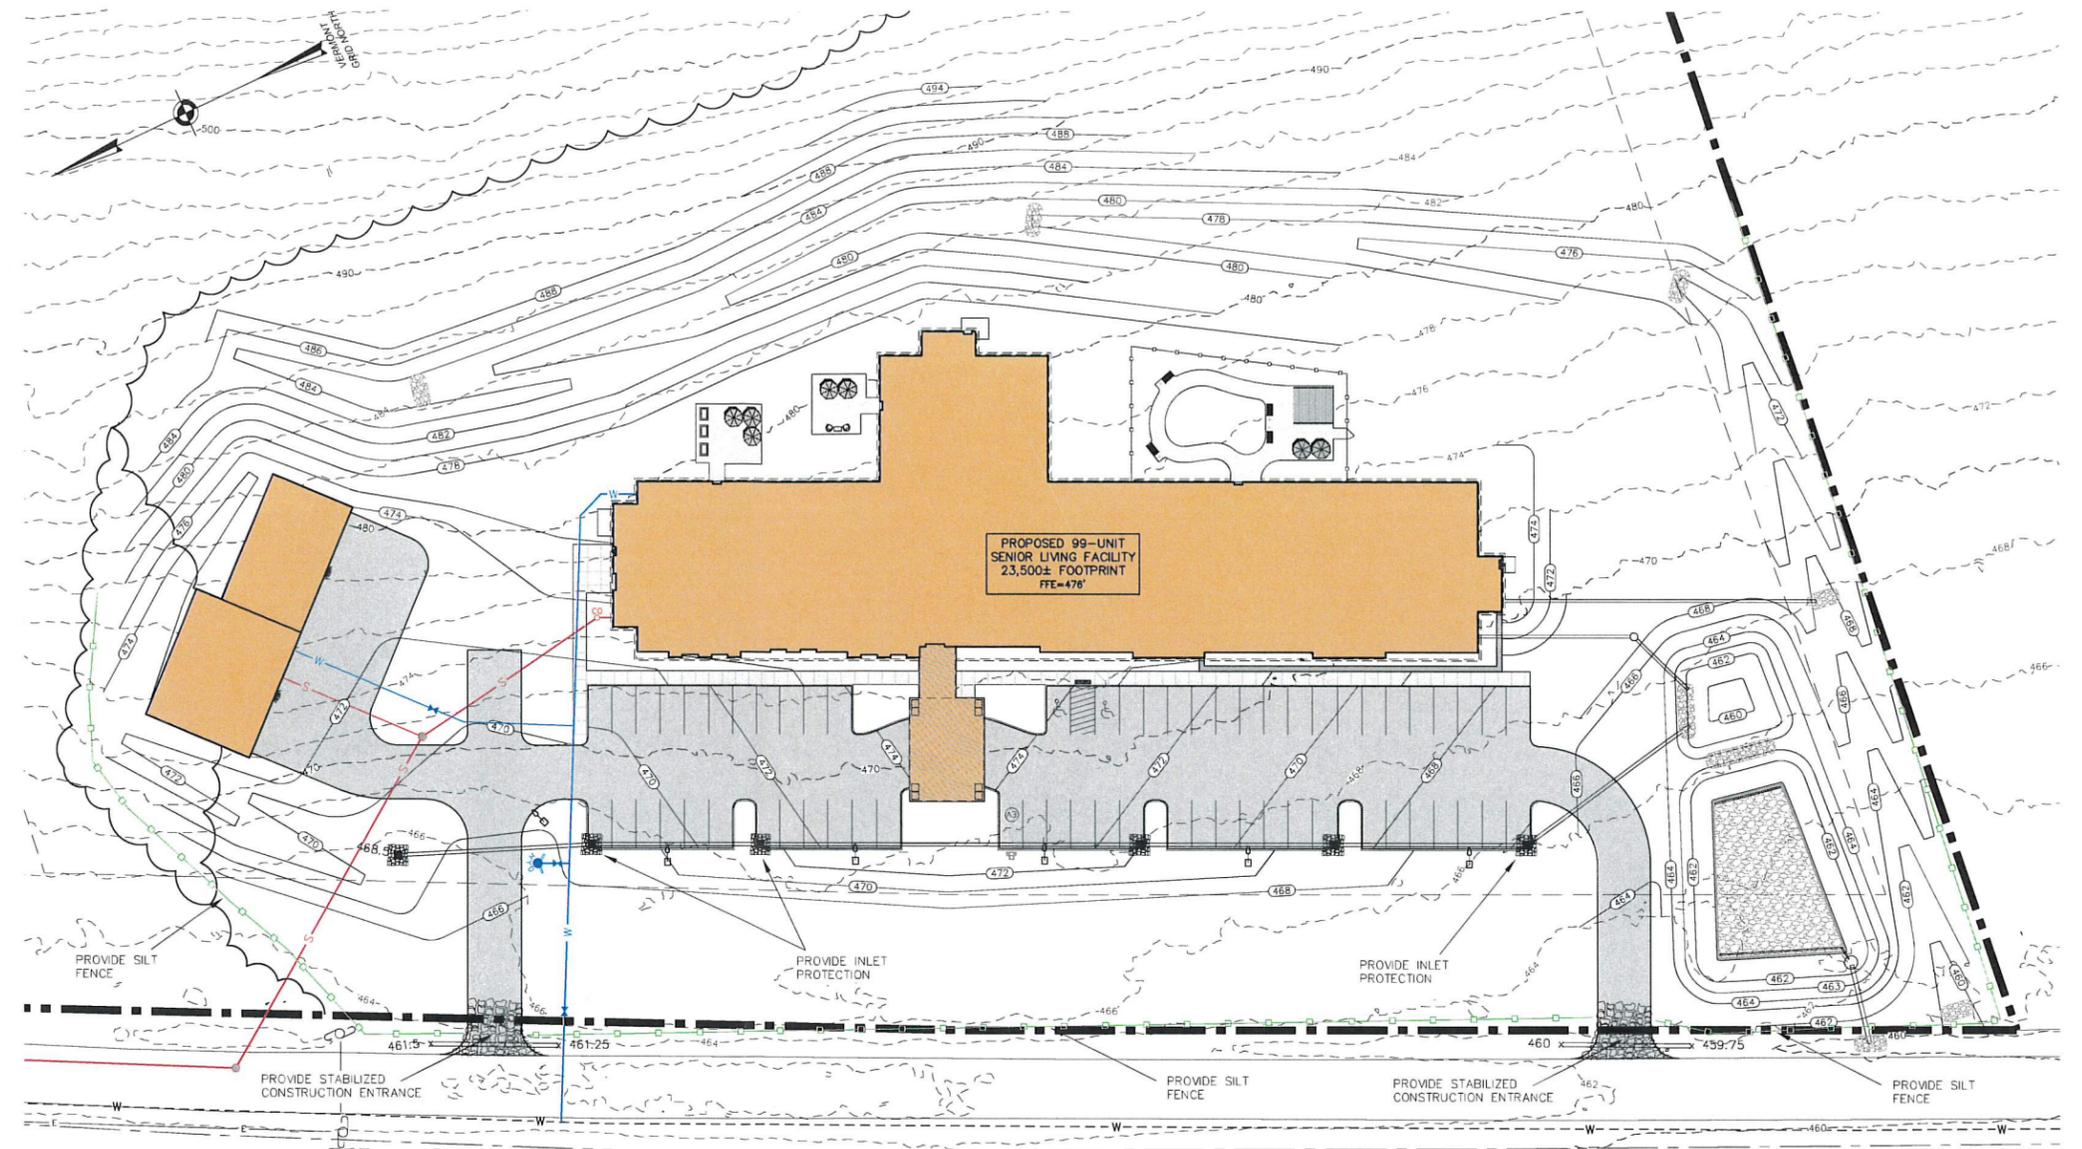


CATCH BASIN DIAMETER	LARGEST PIPE DIA. ALLOWED	SIDEWALL THICKNESS	CONCRETE COVER THICKNESS
36"	18"	4"	6"
48"	30"	5"	10"
60"	36"	6"	12"
72"	48"	7"	18"

- NOTE:** ALL STRUCTURES TO BE PAVED AROUND FOR EASE OF PLOWING IF PAVING TO BE DONE OVER TWO SEASONS. PAVING AROUND STRUCTURES TO BE DONE PRIOR TO OCTOBER 31.
- CATCH BASINS SHALL BE SIZED SUCH THAT:
1. AT ANY ELEVATION, A MINIMUM OF 80% OF THE CIRCUMFERENCE SHALL BE CONCRETE.
 2. THE MINIMUM DISTANCE, AS MEASURED ALONG THE CIRCUMFERENCE, BETWEEN TWO OPENINGS SHALL BE 6'.
 3. THE BASINS SHALL ALSO MEET THE FOLLOWING MINIMUM REQUIREMENTS:



PRECAST CATCH BASIN
NTS

EROSION CONTROL SPECIFICATIONS

1. SEE OTHER DRAWINGS OF THESE PLANS FOR ADDITIONAL STORMWATER AND EROSION CONTROL SPECIFICATIONS AND DETAILS.
2. THE ROADWAY AND YARD FINISH GRADE SLOPES SHALL NOT BE STEEPER THAN 3 ON 1. THE FINISHED GRADE SLOPES SHALL BE IMMEDIATELY GRADED AND MULCHED.
3. ALL DISTURBED AREAS SHALL BE STABILIZED WITH SEEDING AND MULCHING PRIOR TO OCTOBER 1 OF EACH YEAR. ANY DISTURBED AREAS OUTSIDE OF THE ROADWAY SHALL BE IMMEDIATELY SEEDING AND MULCHED WITHIN 15 DAYS.
4. THE EROSION CONTROL METHODS USED DURING CONSTRUCTION OF THE DEVELOPMENT SHALL PROCEED IN THE FOLLOWING SEQUENCE:
 - A) THE CONTRACTOR SHALL INSTALL AND MAINTAIN SILT FENCES, INLET PROTECTION, AND OTHER EROSION CONTROL MEASURES, IF REQUIRED, AS ORDERED BY THE ENGINEER. THE EROSION CONTROL MEASURES SHALL BE MAINTAINED AND REPAIRED AFTER EVERY RAINFALL UNTIL THE NEW IMPROVEMENTS ARE PAVED AND ALL DISTURBED AREAS HAVE BEEN GRASSED. THE REPAIR OF THE EROSION CONTROL MEASURES WILL INCLUDE REMOVING ANY SEDIMENTATION. THE SEDIMENT MAY BE PLACED AS FILL IN THE LOW AREAS, IF APPROVED BY THE ENGINEER.
 - B) THE TOPSOIL SHALL BE REMOVED FROM THE AREAS TO BE GRADED AND STOCKPILED. A SILT FENCE SHALL BE PLACED CONTINUOUSLY AROUND THE BOTTOM OF THE PILE.
 - C) IN AREAS NEAR THE NEW CONSTRUCTION, THE CONTRACTOR SHALL PROTECT THE TRUNKS OF TREES TO BE SAVED WITH WOODEN SNOW FENCING ALONG THE DRILL LINE TO PROTECT THEM FROM INJURY. IN THESE PROTECTED AREAS NO CONSTRUCTION ACTIVITIES SHALL OCCUR. NO STORAGE OF MATERIALS, RUNNING OF MACHINERY, PORTO-LETS ETC. PLACE STAY OUT SIGNS. THESE INSTRUCTIONS MUST BE CONVEYED TO THE CONSTRUCTION CREW.
 - D) THE SITE GRADING WILL THEN BE DONE, AND THE PIPELINES WILL BE INSTALLED IMMEDIATELY FOLLOWING GRADING. THE CONTRACTOR WILL INSTALL AND MAINTAIN INLET PROTECTION AROUND THE CATCH BASINS UNTIL THE ROADWAY HAS BEEN PAVED AND GRASS HAS BEEN ESTABLISHED ON THE SLOPES.
 - E) THE CONTRACTOR WILL TOPSOIL, SEED, AND MULCH THE DISTURBED AREAS AS SOON AS POSSIBLE FOLLOWING COMPLETION OF ADJACENT CONSTRUCTION.

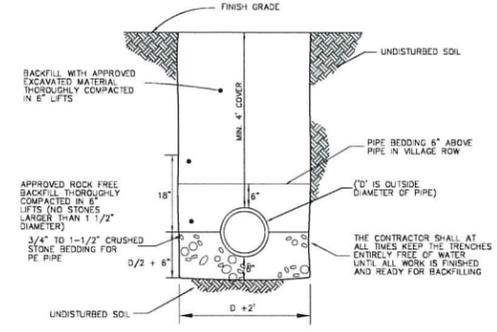

STORM DRAIN TRENCH
NTS

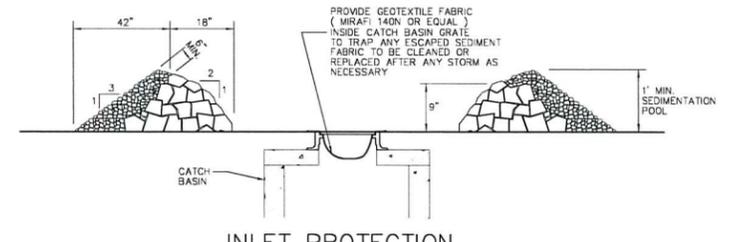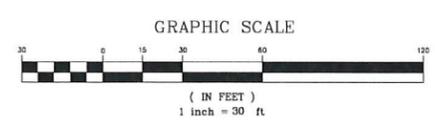

INLET PROTECTION
NTS



DATE: 6-1-22	REVISION: 19-159-D 11-10-19N COMMENTS	BY: SEC
SURVEY: CIRCA	RECORD DRAWING	DATE: 04-08-22
DESIGN: SEC/BVC	PRELIMINARY	JOB: 2307-08
DRAWN: SEC/BVC	SKETCH/CONCEPT	FILE: 2021-08-57
CHECKED: PLO		PLAN SHEET # 5
SCALE: 1"=30'		

Senior Living Facility
Sand Hill Road
Erosion Prevention & Sediment Control Plan

GENERAL SEWER SPECIFICATIONS

GENERAL:

THIS ITEM SHALL CONSIST OF THE EXCAVATION AND BACKFILLING REQUIRED FOR THE COMPLETE CONSTRUCTION OF GRAVITY SANITARY SEWERS, FORCE MAINS, AND ALL APPURTENANCE CONSTRUCTION RELATED THERETO, INCLUDING CHIMNEYS, SERVICE CONNECTIONS, THRUST BLOCKS, AND OTHER ITEMS NECESSARY FOR A COMPLETE SANITARY SEWER SYSTEM AS INDICATED ON THE DRAWINGS.

A. TYPES OF PIPE

1. SPECIES OF PIPE WHICH SHALL BE USED FOR THE VARIOUS PARTS OF WORK ARE AS FOLLOWS:
GRAVITY SEWERS SHALL BE PVC SOLID WALL PIPE MEETING ASTM SPECIFICATIONS D-3034 OR F879.

B. PVC SEWER PIPE

PVC SEWER PIPE SHALL CONFORM IN ALL RESPECTS TO THE LATEST REVISION OF ASTM SPECIFICATIONS D-3034 OR F879, TYPE PSM POLYVINYL CHLORIDE (PVC) SEWER PIPE AND FITTINGS, SDR33. WALL THICKNESS OF ALL PVC SHALL MEET ASTM SPECIFICATIONS FOR SDR33 PIPE. ALL PIPE AND FITTINGS SHALL BE CLEARLY MARKED AS FOLLOWS:

MANUFACTURER'S NAME AND TRADEMARK
NOMINAL PIPE SIZE
MATERIAL DESIGNATION 12454C PVC
LEGEND TYPE PSM SDR33 PVC SEWER PIPE OR
"PS 46 PVC SEWER PIPE"
DESIGNATION ASTM D-3034 OR F879

JOINTS SHALL BE PUSH-ON TYPE USING ELASTOMERIC GASKETS AND SHALL CONFORM TO ASTM D-3212. THE GASKETS SHALL BE FACTORY INSTALLED.

THE PIPE SHALL BE FURNISHED IN NOMINAL 13 FOOT LENGTHS. SUFFICIENT NUMBERS OF SHORT LENGTHS AND FULL MACHINE FITTINGS SHALL BE PROVIDED FOR USE AT MANHOLES, CHIMNEYS, AND CONNECTIONS. ALL CONNECTIONS WILL REQUIRE THE USE OF MANUFACTURED FITTINGS. FIELD FABRICATED, SADDLE-TYPE CONNECTIONS WILL NOT BE CONSIDERED ACCEPTABLE.

ANY PIPE OR FITTING HAVING A CRACK OR OTHER DEFECT OR WHICH HAS RECEIVED A SEVERE BLOW SHALL BE MARKED REJECTED AND REMOVED AT ONCE FROM THE WORK SITE. ALL FIELD CUTS ARE TO BE MADE WITH SAW AND 90 DEGREE MITRE BOX. BEVEL THE CUT END TO THE SAME AS THE FACTORY BEVEL AND REMOVE ALL INTERIOR BURRS. MEASURE AND PLACE A HOLDING MARK ON THE PIPE BEFORE ASSEMBLING.

THE PIPE INSTALLED UNDER THIS SPECIFICATION SHALL BE INSTALLED SO THAT THE INITIAL DEFLECTION, MEASURED AS DESCRIBED HEREIN, DOES NOT EXCEED 0.05 INCH.

DEFLECTION TESTS SHALL BE PERFORMED ON ALL FLEXIBLE PIPE AFTER THE FINAL BACKFILL HAS BEEN PLACED FOR AT LEAST 30 DAYS. THE DEFLECTION TEST SHALL BE RUN USING A RIGID BALL OR MANDREL HAVING A DIAMETER EQUAL TO 95 PERCENT OF THE INSIDE DIAMETER OF THE PIPE. NO MECHANICAL PULLING DEVICES SHALL BE USED DURING THE DEFLECTION TESTS. ALL PIPE NOT MEETING THE DEFLECTION TEST SHALL BE RE-EXCAVATED AND REPLACED AT THE CONTRACTOR'S EXPENSE.

THE MANHOLE WATER STOP GASKET AND STAINLESS STEEL CLAMP ASSEMBLY MUST BE APPROVED BY THE ENGINEER PRIOR TO THE INSTALLATION OF ANY PIPE.

THE CONTRACTOR WILL SUBMIT CERTIFICATION THAT THE MATERIALS OF CONSTRUCTION HAVE BEEN SAMPLED, TESTED, AND INSPECTED, AND THAT THEY MEET ALL THE REQUIREMENTS—INCLUDING WALL THICKNESS—IN ACCORDANCE WITH THE ASTM SPECIFICATIONS FOR ALL PIPE AND FITTINGS TO BE INCLUDED IN THE PROJECT WORK.

PVC PIPE SHALL NOT BE INSTALLED WHEN THE TEMPERATURE DROPS BELOW 32 DEGREES FAHRENHEIT OR GOES ABOVE 100 DEGREES FAHRENHEIT. DURING COLD WEATHER, THE FLEXIBILITY AND IMPACT RESISTANCE OF PVC PIPE IS REDUCED.

EXTRA CARE IS REQUIRED WHEN HANDLING PVC PIPE DURING COLD WEATHER. PVC PIPE SHALL NOT BE STORED OUTSIDE AND EXPOSED TO PROLONGED PERIODS OF SUNLIGHT AS PIPE DISCOLORATION AND REDUCTION IN PIPE IMPACT STRENGTH WILL OCCUR. CANVAS OR OTHER OPAQUE MATERIAL SHALL BE USED TO COVER PVC PIPE STORED OUTSIDE.

C. MANHOLES

THE CONTRACTOR SHALL CONSTRUCT REINFORCED CONCRETE MANHOLES AND DROP MANHOLES TO THE DIMENSIONS AT THE LOCATIONS SHOWN ON THE CONTRACT DRAWINGS. ALL PRECAST REINFORCED CONCRETE MANHOLE SECTIONS SHALL CONFORM TO THE LATEST REVISION OF THE ASTM SPECIFICATIONS C478. THE EXTERIOR OF THE MANHOLE SHALL BE COATED WITH A WATERPROOF SEALANT.

THE FOUNDING SHALL BE CLASS B PRECAST CONCRETE AND SHALL CONFORM TO THE DIMENSIONS INDICATED ON THE PLANS.

SHELVEYS SHALL BE CONSTRUCTED WITH HARDENED RED SEWER BRICK. ALL BRICK SHALL BE TYPE SS MEETING THE STANDARDS IN ASTM C32. INVERTS FOR SEWER MANHOLES SHALL BE AS SHOWN ON THE PLANS AND DETAILS.

INVERTS SHALL HAVE THE EXACT SHAPE OF THE SEWER TO WHICH THEY ARE CONNECTED, AND ANY CHANGE IN SIZE OR DIRECTION SHALL BE GRADUAL AND EVEN.

ALL CONSTRUCTION OF SEWER MANHOLES MUST BE CARRIED OUT TO ENSURE WATERIGHT WORK. ANY LEAKS IN MANHOLES SHALL BE CALKED AND COMPLETELY REPAIRED TO THE SATISFACTION OF THE ENGINEER OR THE ENTIRE STRUCTURE SHALL BE REMOVED AND REBUILT. REPAIRS SHALL NOT BE ALLOWED TO THE EXTERIOR OF THE MANHOLE.

ALL MANHOLES ARE TO BE PROVIDED WITH COPOLYMER POLYPROPYLENE PLASTIC RINGS WITH STEEL REINFORCEMENT TWELVE INCHES (12") ON CENTER. ALL MANHOLES SHALL BE PROVIDED WITH TOUGH, GRAY, CAST IRON MANHOLE FRAMES AND COVERS. ALL IRON CASTINGS SHALL BE THOROUGHLY CLEANED AND THEN COATED WITH HOT TAR BEFORE BEING DELIVERED. FRAMES AND COVERS SHALL BE LEVISED TO 200 TYP. C OR AN APPROVED EQUAL VACUUM RING OR COVER. MANHOLE COVERS SHALL HAVE THE WORD SEWER PRINTED ON THEM.

PRECAST RISERS AND BASES FOR MANHOLES SHALL CONFORM TO ASTM SPECIFICATIONS C-361. THE PIPE OPENING IN THE PRECAST MANHOLE RISER SHALL HAVE A CAST-IN-PLACE FLEXIBLE GASKET OR AN EQUIVALENT SYSTEM FOR PIPE INSTALLATION AS APPROVED BY THE ENGINEER. JOINTS BETWEEN MANHOLE RISERS SHALL BE RUBBER "O" RING SEALS OR SOFT BUTYL JOINT SEALER (ROPE FORM).

THE MANHOLE COVER FRAMES SHALL BE SET TO FINISH GRADE ONLY AFTER THE BASE COURSE PAVING HAS BEEN COMPLETED. MANHOLE RISERS SHALL BE CONSTRUCTED TO GRADE WITH AT LEAST TWO, AND NOT MORE THAN FIVE, COURSES OF BRICK. THE EXTERIOR OF BRICK MANHOLE RISERS SHALL BE PLASTERED WITH CEMENT MORTAR, THE PLASTER BEING CARRIED UP AS THE BRICKWORK PROGRESSES, AND ALL MANHOLE LIFT HOLES SHALL BE GROUDED INSIDE AND OUT WITH EXPANDABLE GROUT.

MANHOLES SHALL BE PLACED AT ALL CHANGES IN SLOPE, SIZE, ALIGNMENT OF PIPE, AT THE ENDS OF EACH LINE, AND AT LEAST EVERY 300 FEET.

D. MASONRY

EACH BRICK SHALL BE WETTED AND COMPLETELY BEDDED IN MORTAR AT ITS BOTTOM, SIDES, AND ENDS IN ONE OPERATION WITH CARE BEING TAKEN TO FILL EVERY JOINT. BRICKWORK SHALL BE WELL-BONDED, AND JOINTS SHALL BE AS CLOSE AS PRACTICABLE. NO BRICK MASONRY SHALL BE LAID IN WATER NOR SHALL ANY WATER BE ALLOWED TO RISE ON OR AROUND ANY BRICK MASONRY UNIT. IT HAS SET AT LEAST 24 HOURS. NO MASONRY SHALL BE LAID IN FREEZING WEATHER.

THE BRICK FOR ORDINARY BRICKWORK SHALL BE COMMON HARD-BURNED LAY BRICK. ALL BRICK SHALL BE REGULAR AND UNIFORM IN SHAPE AND SIZE WITH PLANE, PARALLEL BEDS, AND FACES. ORDINARY BRICK SHALL CONFORM TO ASTM SPECIFICATION C-32, LATEST VERSION, AND SHALL BE GRADE SS.

BRICK MASONRY SHALL BE LAID IN PORTLAND CEMENT MORTAR COMPOSED OF ONE PART PORTLAND CEMENT AND TWO PARTS OF SAND, MEASURED BY VOLUME, TO WHICH NOT MORE THAN 10 POUNDS OF LIME SHALL BE ADDED FOR EACH BAG OF CEMENT. WATER FOR MORTAR SHALL BE CLEAN AND ONLY AN AMOUNT SUFFICIENT TO PRODUCE A WORKABLE MORTAR SHALL BE USED. MORTAR SHALL BE USED WITHIN ONE HOUR FROM THE TIME THE CEMENT WAS ADDED TO THE MIX.

THE SAND FOR MORTAR FOR BRICK MASONRY SHALL BE UNIFORMLY GRADED, CLEAN, SHARP, AND CONTAIN NO GRADES LARGER THAN WILL PASS A ONE-EIGHTH INCH (1/8") MESH SCREEN.

CONSTRUCTION METHODS:

A. EXCAVATION:
EXCAVATIONS SHALL BE MADE TO A POINT AT LEAST SIX INCHES (6") BELOW THE PIPE INVERT TO ACCOMMODATE THE BEDDING MATERIAL. ALL EXCAVATIONS ARE TO BE KEPT DRY WHILE PIPE IS BEING LAID AND UNTIL EACH JOINT AND PIPE HAS BEEN INSPECTED BY THE ENGINEER AND APPROVAL GIVEN TO COMMENCE BACKFILLING OPERATIONS.

B. LAYING SEWER PIPE:
THE BELL END OF THE PIPE SHALL FACE UPWARD AT ALL TIMES AND BE PLACED IN SUCH A POSITION AS TO MAKE THE INVERT EVEN WHEN THE SUCCEEDING SECTION IS INSERTED. WHERE REQUIRED BY ADEQUATE GRADING CONDITIONS, THE CONTRACTOR SHALL FILL ANY GULLY TO MAKE A SUITABLE BEDDING FOR THE SEWER PIPE. THE FILL SHALL BE PNEUMATICALLY COMPACTED TO A 95 PERCENT DRY DENSITY BY THE AASHTO-T-99 METHOD A (STANDARD PROCTOR) TEST, UPON WHICH THE SIX INCHES (6") OF BEDDING MATERIAL SHALL BE PLACED.

ANY PIPE WHICH IS NOT LAID TO GRADE AND ALIGNMENT SHALL BE RELIED TO THE SATISFACTION OF THE ENGINEER. THE BEDDING MATERIAL SHALL BE PLACED AND COMPACTED TO THE FULL WIDTH OF THE PIPE TO A HEIGHT EQUAL TO ONE-HALF THE PIPE DIAMETER AND FOR THE FULL WIDTH OF THE EXCAVATED TRENCH AND AS SHOWN ON THE ACCEPTED PLANS.

C. BACKFILL:
BACKFILL SHALL CONSIST OF APPROVED MATERIAL PLACED IN SIX INCH (6") LAYERS WITH EACH LAYER BEING THOROUGHLY COMPACTED TO NOT LESS THAN 95 PERCENT OF MAXIMUM DRY DENSITY AS DETERMINED BY THE AASHTO-T-99 STANDARD PROCTOR BY MEANS APPROVED BY THE ENGINEER.

THE BACKFILL SHALL BE BROUGHT UP EVENLY ON BOTH SIDES OF THE PIPE FOR ITS FULL LENGTH. WALKING OR WORKING ON THE COMPLETED PIPELINE, EXCEPT AS MAY BE NECESSARY IN TAPPING OR BACKFILLING, SHALL NOT BE PERMITTED UNTIL THE TRENCH HAS BEEN BACKFILLED TO A HEIGHT OF AT LEAST TWO FEET (2') ON TOP OF THE PIPES. DURING CONSTRUCTION, ALL OPENINGS TO THE PIPELINES SHALL BE PROTECTED FROM THE ENTIRETY OF EARTH OR OTHER MATERIALS.

D. CONCRETE CRADLE AND ENCASEMENT FOR PIPE:
WHERE REQUIRED ON THE PLANS OR AS DIRECTED BY THE ENGINEER, A CONCRETE CRADLE SHALL BE USED TO BOLSTER AND STRENGTHEN PIPE. WHERE REQUIRED ON THE PLANS OR AS DIRECTED BY THE ENGINEER, CONCRETE ENCASEMENT OF SEWER SHALL BE MADE TO PROTECT NEARBY WELLS OR WATERLINES FOR STREAM CROSSINGS OR FOR SIMILAR PURPOSES. ALL CONCRETE WILL BE CLASS B AS DEFINED IN THE VERMONT STANDARD SPECIFICATIONS FOR CONSTRUCTION, SECTION D01, AND WILL MEET THE REQUIREMENTS OF THAT SECTION.

E. FROST PROTECTION FOR SHALLOW SEWERS:

SEWERS WITH LESS THAN FIVE AND ONE-HALF FEET (5 1/2') OF COVER OVER THE CROWN OR WHERE INDICATED ON THE PLANS SHALL BE PROTECTED AGAINST FREEZING BY INSTALLATION OF TWO 2" THICK (4" TOTAL) STYROFOAM SM INSULATING SHEETS WITH A TOTAL WIDTH OF FOUR FEET (4') OR TWICE THE PIPE DIAMETER, WHICHEVER IS GREATER. THE SHEETS SHALL BE PLACED SIX INCHES (6") ABOVE THE CROWN OF THE SEWER AFTER COMPACTION OF THE SIX INCH LIFT IMMEDIATELY ABOVE THE CROWN. CARE SHALL BE EXERCISED BY THE CONTRACTOR DURING BACKFILL AND COMPACTED OVER THE STYROFOAM SM SHEETS SHALL MEET THE COMPRESSIVE STRENGTH REQUIREMENTS OF ASTM D1621-73 AND SHALL BE AS MANUFACTURED BY DOW CHEMICAL COMPANY, MIDLAND, MICHIGAN, OR EQUAL. IN NO CASE SHALL THE SEWER LINES HAVE LESS THAN FOUR (4') FEET OF COVER OVER THE TOP OF THE PIPE.

F. LEAKAGE TESTS AND ALLOWANCES FOR GRAVITY SEWERS:

THE LOW PRESSURE AIR TEST WILL BE USED TO SIMULATE INFILTRATION OR EXFILTRATION RATES INTO OR OUT OF ALL GRAVITY SEWERS. THE CONTRACTOR WILL FURNISH ALL FACILITIES AND PERSONNEL FOR CONDUCTING THE TEST. FINAL ACCEPTANCE OF THE SEWER SHALL DEPEND UPON THE SATISFACTORY PERFORMANCE OF THE SEWER UNDER TEST CONDITIONS. THE TEST SHALL BE PERFORMED ON PIPE BETWEEN ADJACENT MANHOLES AFTER BACKFILLING HAS BEEN COMPLETED AND COMPACTED.

ALL WYES, TEES, LATERALS, OR END-OF-SIDE SEWER STUBS SHALL BE PLUGGED WITH FLEXIBLE-JOINT CAPS OR AN ACCEPTABLE ALTERNATE, SECURELY FASTENED TO WITHSTAND THE INTERNAL TEST PRESSURE. SUCH PLUGS OR CAPS SHALL BE READILY REMOVABLE, AND THEIR REMOVAL SHALL PROVIDE A SOCKET SUITABLE FOR MAKING A FLEXIBLE-JOINTED LATERAL CONNECTION OR EXTENSION.

BEFORE TESTING FOR ACCEPTANCE, THE PIPE SHOULD BE CLEANED BY PASSING THROUGH THE PIPE A FULL GAUGE SQUEGEE. IT SHALL BE THE RESPONSIBILITY OF THE CONTRACTOR TO HAVE THE PIPE CLEANED IMMEDIATELY FOLLOWING THE PIPE CLEANING. THE PIPE INSTALLATION SHALL BE TESTED WITH LOW-PRESSURE AIR.

AIR SHALL BE SLOWLY SUPPLIED TO THE PLUGGED AIR INSTALLATION UNTIL THE INTERNAL AIR PRESSURE REACHES FOUR POUNDS PER SQUARE INCH (4.0 PSI) GREATER THAN THE AVERAGE BACK PRESSURE OF ANY GROUNDWATER GAUGE SQUEGEE. IT SHALL BE THE RESPONSIBILITY OF THE CONTRACTOR TO HAVE THE PIPE CLEANED IMMEDIATELY FOLLOWING THE PIPE CLEANING. THE PIPE INSTALLATION SHALL BE TESTED WITH LOW-PRESSURE AIR.

THE PIPELINE SHALL BE CONSIDERED ACCEPTABLE WHEN TESTED AT AN AVERAGE PRESSURE OF THREE POUNDS PER SQUARE INCH (3.0 PSI) GREATER THAN THE AVERAGE BACK PRESSURE OF ANY GROUNDWATER THAT MAY SUBMERGE THE PIPE IF:

- 1. THE TOTAL RATE OF AIR LOSS FROM ANY SECTION TESTED IN ITS ENTIRETY BETWEEN MANHOLE AND CLEANOUT STRUCTURE DOES NOT EXCEED 2.0 CUBIC FEET PER MINUTE; OR
- 2. THE SECTIONS UNDER TEST DOES NOT USE AIR AT A RATE GREATER THAN 0.0030 CUBIC FEET PER MINUTE PER SQUARE FOOT OF INTERNAL PIPE SURFACE.

THE REQUIREMENTS OF THIS SPECIFICATION SHALL BE CONSIDERED SATISFIED IF THE TIME REQUIRED IN SECONDS FOR THE PRESSURE TO DECREASE FROM 3.5 OR 2.5 PSI GREATER THAN THE AVERAGE BACK PRESSURE OF ANY GROUNDWATER THAT MAY SUBMERGE THE PIPE IS NOT LESS THAN THAT COMPUTED ACCORDING TO THE FOLLOWING TABLE:

DIAMETER (INCHES)	TIME (SEC./100 FT.)
3	10
4	15
6	40
8	75
10	110
12	148
16	238
18	296
21	485
24	674
27	785
30	851
33	939
36	1,020
39	1,105
42	1,190

THE TABLE GIVES THE REQUIRED TEST TIME IN SECONDS PER 100 FOOT LENGTHS OF PIPE FOR A GIVEN DIAMETER. IF THERE IS MORE THAN ONE PIPE SIZE IN THE SECTION OF LINE BEING TESTED, COMPUTE THE TIME FOR EACH DIAMETER AND SUM THE TIMES TO FIND THE TOTAL REQUIRED TEST TIME.

IF THE PIPE INSTALLATION FAILS TO MEET THESE REQUIREMENTS, THE CONTRACTOR SHALL DETERMINE AT HIS OR HER OWN EXPENSE THE SOURCE OR SOURCES OF LEAKAGE AND SHALL REPAIR (IF THE EXTENT AND TYPE OF REPAIRS PROPOSED BY THE CONTRACTOR APPEAR REASONABLE TO THE ENGINEER) OR REPLACE ALL DEFECTIVE MATERIALS OR WORKMANSHIP. THIS OTHER SHAPE OF PIPE INSTALLATION SHALL MEET THE REQUIREMENTS OF THIS TEST BEFORE BEING CONSIDERED ACCEPTABLE.

SINCE THIS TEST DOES NOT DETERMINE THE TIGHTNESS OF MANHOLES, THEY SHALL BE TESTED SEPARATELY. THE EXFILTRATION LEAKAGE ALLOWANCE OUT OF MANHOLES SHALL BE NO GREATER THAN ONE GALLON PER DAY PER VERTICAL FOOT TO DEPTH. THE MANHOLE SHALL BE FILLED WITH WATER TO A POINT ONE FOOT (1') ABOVE THE HIGHEST POINT BETWEEN MANHOLE SECTIONS. IN AREAS OF HIGH GROUNDWATER, THERE SHALL BE NO VISIBLE LEAKAGE DUE TO INFILTRATION. IF A VACUUM TEST IS DESIRED, THE FOLLOWING PROCEDURE SHALL BE FOLLOWED: THESE PREPARED METHODS OF TESTING MANHOLES FOR LEAKAGE METHODS FOR LEAKAGE OF AIR AND THE TOP OF THE MANHOLE CONE SECTION AND PUMPING AIR OUT OF THE MANHOLE, CREATING A VACUUM AND HOLDING IT FOR 15 MINUTES.

- 1. ALL LIFTING HOLES AND EXTERIOR JOINTS SHALL BE FILLED AND POINTED WITH AN APPROVED NON-SHRINKING MORTAR. THE COMPLETED MANHOLE SHALL NOT BE BACKFILLED UNTIL TESTING. MANHOLES WHICH HAVE BEEN BACKFILLED SHALL BE EXCAVATED TO EXPOSE THE ENTIRE EXTERIOR PRIOR TO VACUUM TESTING OR THE MANHOLE SHALL BE TESTED FOR LEAKAGE BY MEANS OF A HYDROSTATIC TEST. REPAIRS SHALL ONLY BE MADE TO THE EXTERIOR OF THE MANHOLE.

- 2. ALL PIPE AND OTHER OPENINGS INTO THE MANHOLE SHALL BE SUITABLY PLUGGED IN A MANNER TO PREVENT DISPLACEMENT.
- 3. A PLATE WITH AN INFLATABLE RUBBER RING THE SIZE OF THE TOP OF THE MANHOLE SHALL BE INSTALLED BY INFLATING THE RING WITH AIR TO PRESSURE ADEQUATE TO PREVENT LEAKAGE OF AIR BETWEEN THE RUBBER RING AND MANHOLE WALL.

- 4. AIR SHALL THEN BE PUMPED OUT OF THE MANHOLE THROUGH AN OPENING IN THE PLATE UNTIL A VACUUM IS CREATED INSIDE OF THE MANHOLE EQUAL TO TEN INCHES (10") OF MERCURY ON AN APPROVED VACUUM GAUGE. THE REMOVAL OF AIR SHALL THEN BE STOPPED AND THE TEST TIME BEGUN.
- 5. THE VACUUM MUST NOT DROP TO BELOW NINE INCHES (9") OF MERCURY WITH A TWO MINUTE TEST PERIOD. IF MORE THAN ONE INCH (1") DROPS OF VACUUM OCCURS WITHIN THE TWO MINUTE TEST PERIOD, THE MANHOLE HAS FAILED AND SHALL BE REPAIRED OR RECONSTRUCTED AND THEN RE-TESTED.

- 6. FOLLOWING SATISFACTORY TEST RESULTS, THE MANHOLE MAY BE BACKFILLED.

IT IS NOTED THAT ALL EXISTING SANITARY SEWERS SHALL BE KEPT OPERATIONAL UNTIL NEW WORK HAS BEEN TESTED AND APPROVED BY THE ENGINEER. AT SUCH TIME, EXISTING SEWERS AND SEWER SERVICES SHALL BE CONNECTED TO THE NEW SEWERS.

G. LEAKAGE AND PRESSURE TESTING FOR FORCE MAIN

ALL PIPELINES SHALL BE TESTED IN ACCORDANCE WITH THE VERMONT DEPARTMENT OF WATER RESOURCES ENVIRONMENTAL PROTECTION RULES, LATEST EDITION. A LEAKAGE AND PRESSURE TEST SHALL BE PERFORMED CONCURRENTLY.

THE HYDROSTATIC TEST PRESSURE SHALL BE A MINIMUM OF 80 PSI AT THE HIGHEST POINT ALONG THE TEST SECTION AND SHALL NOT VARY BY MORE THAN FIVE PSI DURING THE ENTIRE TWO HOUR TEST. IF AND WHEN DURING THE TEST THE PRESSURE DROPS BY FIVE PSI, THE QUANTITY OF WATER REQUIRED TO RESTORE THE TEST PRESSURE SHALL BE MEASURED.


AT THE END OF THE TWO HOUR TEST, THE PRESSURE SHALL BE RETURNED TO THE TEST PRESSURE AND THE ADDITIONAL VOLUME OF WATER MEASURED. THE TOTAL AMOUNT OF WATER USED DURING AND AT THE END OF THE TEST SHALL CONSTITUTE THE ACTUAL LEAKAGE. THE MAXIMUM ALLOWABLE LEAKAGE SHALL BE DETERMINED BY THE FOLLOWING FORMULA:

$$L = \frac{SD^3}{133,200}$$

WHERE: L = LEAKAGE IN GALLONS PER HOUR
D = DIAMETER OF PIPE IN INCHES
P = AVERAGE TEST PRESSURE IN PSI
S = LENGTH OF PIPE BEING TESTED


- H. CLEANING PRELINES AND APPURTENANCES:
UPON COMPLETION OF CONSTRUCTION, ALL DIRT AND OTHER FOREIGN MATERIAL SHALL BE REMOVED FROM PIPELINES AND THEIR APPURTENANCE CONSTRUCTIONS. NO MATERIALS SHALL BE LEFT IN THE PIPELINES TO IMPERE NORMAL FLOW THROUGH THEM.
- I. SEWER SERVICE CONNECTIONS:
WHERE REQUIRED ON THE PLANS, SEWER SERVICE CONNECTIONS FOR ONE HOUSE SHALL BE CONSTRUCTED OF SIX INCH (6") PIPE UNLESS OTHERWISE NOTED ON THE PLANS OF THIS MATERIAL SPECIFIED UNDER THIS SECTION. THE PIPE SHALL BE LAID AND ITS JOINTS MADE AS REQUIRED FOR SEWER CONSTRUCTION IN THIS SPECIFICATION.

- J. CLEANOUTS FOR SEWERS:
CLEANOUTS FOR GRAVITY SEWERS AND FORCE MAINS SHALL BE PROVIDED EVERY 100 FT OR WHERE THE SUM OF BENDS = 45 DEGREES. CLEANOUT FRAMES AND COVERS SHALL BE OF TOUGH GRAY CAST IRON. CASTINGS SHALL BE TRUE TO PATTERN AND FREE FROM FLAWS. THE BEARING SURFACE OF CLEANOUT FRAMES AND COVERS AT LEAST SHALL BE MACHINED TO GIVE CONFORMING CONTACT THROUGHOUT THEIR CIRCUMFERENCE. ALL IRON CASTINGS SHALL BE THOROUGHLY CLEANED AND THEN COATED WITH HOT COAL TAR BEFORE BEING DELIVERED.

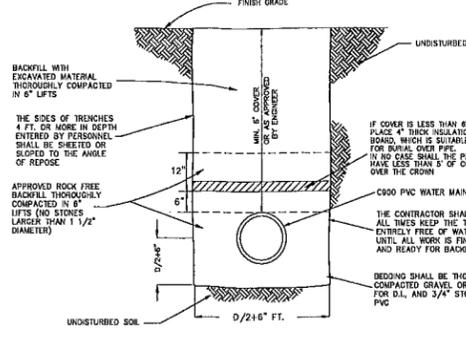


TYPICAL WATER TRENCH

NTS

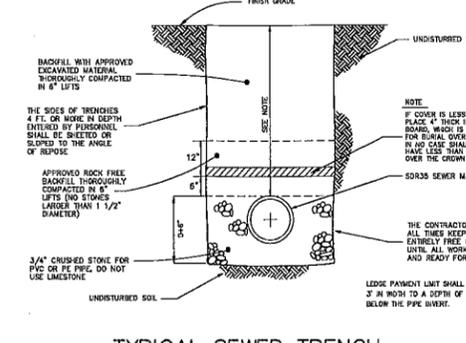


TYPICAL SEWER TRENCH

NTS

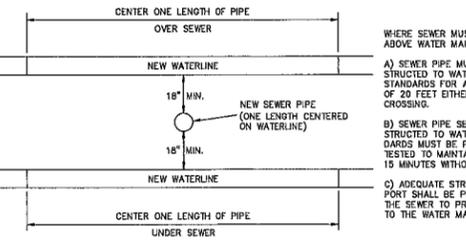

SEWER / WATER SEPARATION DETAIL FOR CROSSINGS

NTS

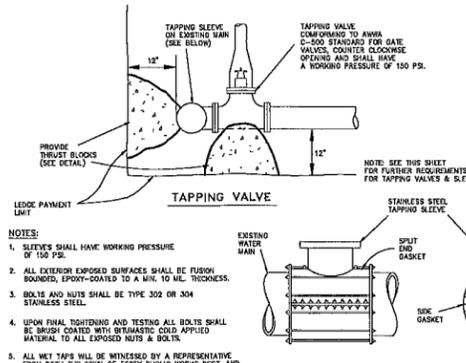

TAPPING VALVE & SLEEVE DETAIL

NTS

GENERAL WATER SPECIFICATIONS

1.1 GENERAL:

This item shall consist of the labor, equipment, and material required for the complete construction of the watermain and services which shall include excavation, backfilling, pipe, valves, tees, hydrants, elbows, reducers, and all other appurtenances necessary for a complete watermain system as indicated on the accepted drawings. All materials and installations shall be approved by the local municipal water authority.

1.2 WATER PIPE MATERIALS:

PVC PIPE

Pipe shall be a minimum diameter of six inches (6") and conform to current AWWA C110 or ANSI Specification A21.10. Push-on joint pipe shall conform to minimum thickness Class 52. Push-on joint accessories shall conform to applicable requirements of AWWA C111 or ANSI Specification A21.11.

Pipe shall be cement mortar-lined on the inside in accordance with AWWA C104 or ANSI Specification A21.4 except that the cement-lining thickness shall not be less than three-sixteenths inch (3/16"). A plus tolerance of one-eighth inch (1/8") will be permitted.

TRACER WIRE

Tracer wire (12 AWG) shall be installed adjacent to (on top of or beside) all water pipe that is installed. Wire to be covered by soil when the water trench is backfilled.

1.2 FITTINGS:

Ductile iron fittings shall be cement-lined, have 300 pounds working pressure, and be in accordance with AWWA C-104, C-111, and C-112 or C-153 for compact fittings. Mechanical joint nuts and bolts shall be high strength, low alloy steel per ANSI A-211.1. Ductile iron fittings larger than twelve inches (12") shall have a standard body length equal to Class 52 ductile iron fittings. All fittings will be placed in lieu of ductile iron fittings in sizes larger than twelve inches (12").

Mechanical joint nuts and bolts shall be used on all vertical band and as shown on the plans.

1.4 GATE VALVE RESILIENT SEAT:

VALVES SHALL BE KENNEDY K5-RW M1 751. VALVES SHALL BE MANUFACTURED IN NORTH AMERICA TO MEET ALL REQUIREMENTS OF AWWA SPECIFICATIONS C-315. VALVES TWELVE INCHES (12") AND SMALLER SHALL BE BUBBLE-TIGHT, ZERO LEAKAGE AT 200 PSI WORKING PRESSURE. VALVES SHALL HAVE NON-RISING STEMS, OPEN COUNTDOWN, AND BE PROVIDED WITH A TWO INCH (2") SQUARE OPERATING RIT WITH ARROW CAST IN METAL TO INDICATE DIRECTION OF OPENING.

Each valve shall have maker's name, pressure rating, and year in which manufactured cast on the body. Prior to shipment from the factory, each valve shall be tested by hydrostatic pressure equal to twice the specified working pressure. Buried valves shall be installed with a valve box.

1.5 VALVE BOXES:

Cast iron three-piece slide-type; five and one-fourth inch (5 1/4") short; six foot (6') trench depth.

Cast iron cover marked "WATER" and indicating direction of opening.

1.6 FIRE HYDRANTS:

All hydrants are to be 3-3/4" minimum diameter and limited to the following make:
Model: Cantonian 250 A423

Main Valve Opening: 5 1/4 inches
Nozzle Arrangement: Two 2 1/2 inch hose nozzles with (6) threads per inch. One 4 1/2 inch pumper nozzle with (4) threads per inch. 1" Storz connection
Inlet Connection: 6 inch mechanical joint
Operating Nut: Standard 1 inch pentagon
Direction of Opening: Counter-clockwise
Depth of Bury: Hydrant shall be installed to the manufacturer's instructions with nozzles about 18" above finish grade.

1.7 HYDRANT BRANCHES:

Hydrant assemblies shall consist of a six inch (6") mechanical joint gate valve conforming to AWWA C-509, a four foot (4') length of six inch (6") Class 52 ductile iron pipe with a cement-lining; and the fire hydrant.

The hydrant shall have (18"-21") clearance between the center of the stem or cap and the ground. For single-family house subdivisions, there will be at least one hydrant at each intersection and a maximum of 500 feet (500') between hydrants with a minimum water flow of 500 gallons per minute with a 20 psi residual pressure from each hydrant.

1.8 WATER SERVICE CONNECTION:

A. GENERAL REQUIREMENTS

The Contractor shall install an eight inch (8") 9000 PVC (D1818) water service as indicated on the contract drawings or as directed by the Engineer. The service shall include an 8 inch (8") gate valve.

B. INSTALLATION

Pipes, fittings, and accessories shall be carefully handled to avoid damage. Prior to the date of acceptance of the project work by the Owner, the Contractor shall replace any new pipe or accessory found to be defective at any time, including after installation, at no expense to the Owner. All installation and testing shall be done in accordance with AWWA Standard C-600 and ANSI Specification A21.1.

All pipes showing cracks shall be rejected. If cracks occur in the pipe, the Contractor may, at his own expense and with the approval of the Engineer, cut off the cracked portions at a point at least twelve inches (12") from the visible limits of the crack and use the sound portion of the pipe. All pipes and fittings shall be cleared of all foreign matter and debris prior to installation and shall be kept clean until the time of acceptance by the Owner.

At all times, when the pipe laying is not actually in progress, the open ends of the pipe shall be closed by temporary water-tight plugs or by other approved means. If water is in the trench when work is resumed, the plug shall not be removed until danger of water entering the pipe has passed. The pipe shall be installed in trenches and at the line and grade shown on the Contract Drawings.

At all times, when the pipe laying is not actually in progress, the open ends of the pipe shall be closed by temporary water-tight plugs or by other approved means. If water is in the trench when work is resumed, the plug shall not be removed until danger of water entering the pipe has passed. The pipe shall be installed in trenches and at the line and grade shown on the Contract Drawings.




At all times, when the pipe laying is not actually in progress, the open ends of the pipe shall be closed by temporary water-tight plugs or by other approved means. If water is in the trench when work is resumed, the plug shall not be removed until danger of water entering the pipe has passed. The pipe shall be installed in trenches and at the line and grade shown on the Contract Drawings.

At all times, when the pipe laying is not actually in progress, the open ends of the pipe shall be closed by temporary water-tight plugs or by other approved means. If water is in the trench when work is resumed, the plug shall not be removed until danger of water entering the pipe has passed. The pipe shall be installed in trenches and at the line and grade shown on the Contract Drawings.

Any deflection joints shall be within the limits specified by the manufacturer. All piping and appurten

GENERAL CONSTRUCTION NOTES

- ALL WORK AND MATERIALS SHALL BE APPROVED BY AND IN ACCORDANCE WITH THE LATEST VERMONT AGENCY OF TRANSPORTATION STANDARD SPECIFICATIONS FOR CONSTRUCTION, THE MANUAL ON UNIFORM TRAFFIC CONTROL DEVICES, THE TOMB OF CASTLETON REQUIREMENTS, THE WRITTEN TECHNICAL SPECIFICATIONS, AND THESE PLANS.
- THE CONTRACTOR SHALL CONTACT ALL UTILITIES BEFORE EXCAVATION TO VERIFY THE LOCATION OF ANY UNDERGROUND LINES. THE CONTRACTOR SHALL NOTIFY "DIGSAFE" AT 1-800-235-4977 PRIOR TO ANY EXCAVATION.
- UTILITIES INFORMATION SHOWN HEREON WERE OBTAINED FROM BEST AVAILABLE SOURCES AND MAY OR MAY NOT BE EITHER ACCURATE OR COMPLETE. THE CONTRACTOR SHALL VERIFY THE EXACT LOCATION OF EXISTING UTILITIES AND SHALL BE RESPONSIBLE FOR ANY DAMAGE TO ANY UTILITY, PUBLIC OR PRIVATE, SHOWN OR NOT SHOWN HEREON. THE CONTRACTOR SHALL CONTACT OR RECONNECT ALL UTILITIES TO THE NEAREST SOURCE THROUGH COORDINATION WITH UTILITY OWNER.
- THE CONTRACTOR SHALL BE RESPONSIBLE FOR DEMOLITION AND REMOVAL OF ALL EXISTING VEGETATION, PAVEMENT AND STRUCTURES NECESSARY TO CONSTRUCT THIS PROJECT UNLESS OTHERWISE NOTED ON THESE PLANS. THE CONTRACTOR SHALL REMOVE ALL EXCESS MATERIAL, DEBRIS AND TRASH FROM THE SITE UPON COMPLETION OF CONSTRUCTION, UNLESS OTHERWISE DIRECTED BY THE ENGINEER.
- THE CONTRACTOR SHALL BE RESPONSIBLE AT HIS OWN EXPENSE FOR ENSURING THAT THE DUST CREATED AS A RESULT OF CONSTRUCTION DOES NOT CREATE A NUISANCE OR A SAFETY HAZARD. WHEN AND WHEN NECESSARY BY THE ENGINEER, THE CONTRACTOR SHALL BE REQUIRED TO WET SECTIONS OF THE CONSTRUCTION AREA WITH WATER, APPLY CALCIUM CHLORIDE OR SWEEP ASPHALT ROADS WITH A POWER BROOM AS DUST CONTROL.
- ANY SURFACES, LINES, OR STRUCTURES WHICH HAVE BEEN DAMAGED BY THE CONTRACTOR'S OPERATIONS SHALL BE RESTORED TO THE CONDITION AT LEAST EQUAL TO THAT IN WHICH THEY WERE FOUND IMMEDIATELY PRIOR TO THE BEGINNING OF OPERATIONS.
- THE DESIGN OF THESE PLANS SHALL BE INSPECTED BY O'LEARY-BURKE CIVIL ASSOCIATES, P.C. OF ESSEX JUNCTION, VERMONT, TO ENSURE COMPLIANCE WITH THE APPLICABLE PLANS AND REQUIREMENTS. O'LEARY-BURKE WAIVES ANY AND ALL RESPONSIBILITY AND LIABILITY FOR PROBLEMS THAT MAY ARISE FROM THE FAILURE OF THE CONTRACTOR TO FOLLOW THESE PLANS, SPECIFICATIONS AND THE DESIGN INTENT THAT THE PLANS CONVEY, AND FROM FAILURE TO HAVE BEEN ADVISED TO INSPECT THE WORKS AND TESTS IN PROGRESS.
- FOR ANY WORK WITHIN THE HIGHWAY RIGHT-OF-WAY A MINIMUM OF ONE-WAY TRAFFIC SHALL BE MAINTAINED AT ALL TIMES. CONTINUOUS TWO-WAY TRAFFIC WILL BE REQUIRED AT NIGHT, DURING PEAK-HOURS, AND WHEN NECESSARY DURING ACTUAL CONSTRUCTION ACTIVITIES. UNIFORMED TRAFFIC CONTROL OFFICERS SHALL DIRECT TRAFFIC DURING PEAK HOURS WHEN THERE IS ONE-WAY TRAFFIC OR WHEN DEEMED NECESSARY BY THE TOWN OR STATE. TEMPORARY CONSTRUCTION SIGNS AND TRAFFIC CONTROL DEVICES SHALL BE DIRECTED BY THE CONTRACTOR IN ACCORDANCE WITH STATE AND TOWN STANDARDS.
- TO ASSURE COMPLIANCE WITH THE PLANS, THE CONTRACTOR SHALL NOTIFY THE TOWN ENGINEER AND THE COMMUNITY RELATIONS OFFICER IN ADVANCE OF STARTING ANY WORK, CUTTING THE PAVEMENT, BEGINNING THE INSTALLATION OF ANY UTILITIES, BURNING IN ANY NEW GRAVEL FOR THE NEW BASE, PAVING AND FINAL INSPECTION.
- THE HORIZONTAL AND VERTICAL SEPARATION FOR SEWER AND WATER LINES SHALL BE INSTALLED IN ACCORDANCE WITH THE LATEST EDITION OF THE "TEN STATE STANDARDS - RECOMMENDED STANDARDS FOR WATER."
- TOPSOIL SHALL BE STOCKPILED, SEED, AND MULCHED UNTIL RELOADED. HAY BALES SHALL BE PLACED AND STAKED CONTINUOUSLY AROUND THE BOTTOM OF THE TOPSOIL PILES.
- HEALTHY EXISTING TREES AS SHOWN ON THE SITE PLAN TO BE SAVED SHALL BE PROTECTED BY THE CONTRACTOR.
- OPEN CUT AREAS SHALL BE MATCHED OUTSIDE OF ACTUAL WORK AREAS, AND HAY BALES SHALL BE EMPLOYED TO CONTAIN DIRT WASH AND RUNOFF TO THE IMMEDIATE OPEN AREA AS ORDERED BY THE ENGINEER.
- AT COMPLETION OF GRADING, SLOPES, DITCHES, AND ALL DISTURBED AREAS SHALL BE SMOOTH AND FREE OF POCKETS WITH SUFFICIENT SLOPE TO ENSURE DRAINAGE.
- ALL FILL SHALL BE PLACED IN 6 INCH LIFTS AND THOROUGHLY COMPACTED TO 85% OF MAXIMUM DENSITY AT OPTIMUM MOISTURE CONTENT AS DETERMINED BY ASTM 698 STANDARD PROCTOR, UNLESS OTHERWISE SPECIFIED.
- THE CONTRACTOR SHALL INSTALL EROSION CONTROL DEVICES AS NEEDED TO PREVENT RESEMENTATION. THE HARVEST BANKS, SILT FENCES, STORMS, AND OTHER EROSION CONTROL DEVICES SHALL BE MAINTAINED AND REPAIRED BY THE CONTRACTOR AFTER EVERY RAINFALL OF 1/2 INCH OR MORE UNTIL ALL DISTURBED AREAS HAVE BEEN GRADED AND APPROVED BY THE ENGINEER. THE MAINTENANCE OF THE EROSION CONTROL DEVICES WILL INCLUDE REMOVAL OF ANY ACCUMULATED SEDIMENTATION.

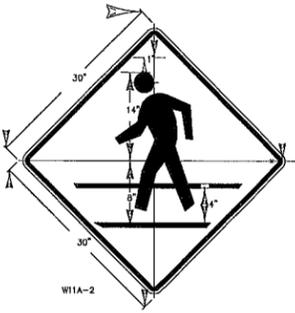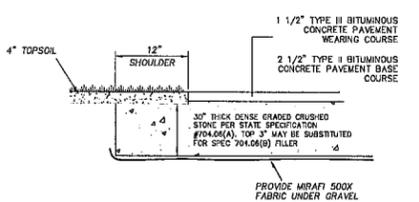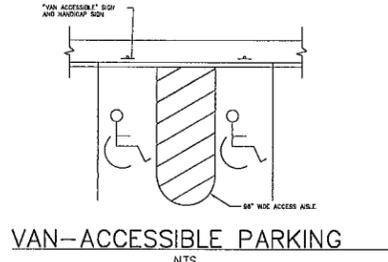

NOTES :

- CURBING SHALL BE CONSTRUCTED IN 10' SECTIONS WITH 1/8" JOINT BETWEEN SECTIONS.
- CURBING EXPANSION JOINTS SHALL BE CONSTRUCTED EVERY 30' AND SHALL BE CONSTRUCTED OF MATERIAL CONFORMING TO AASHTO DESIGNATION M-153 (1/2" SPONGE RUBBER OR CORK.)
- ALL EXPOSED SURFACES TO RECEIVE 2 COATS OF AN ANTI-SPALLING COMPOUND.

CONCRETE CURB
NTS

COLORS
ALL THE WARNING SIGNS SHOWN ON THE SHEET SHALL HAVE BLACK TEXT AND SYMBOLS ON REFLECTORIZED YELLOW BACKGROUND EXCEPT AS OTHERWISE NOTED. THE COLORS SHALL AND TRANSPORTATION OFFICIALS AND APPROVED BY THE DEPARTMENT OF TRANSPORTATION, FEDERAL HIGHWAY ADMINISTRATION.











MATERIALS
ANY OF THE FOLLOWING, OF THE MINIMUM THICKNESS NOTED.

FLAT SHEET ALUMINUM	30" x 30"	0.060"
HIGH DENSITY OVERLAIN PLYWOOD		1/2"
GALVANIZED FLAT SHEET STEEL	16 GAGE	

THE REFLECTIVE MATERIAL SHALL BE REFLECTIVE SHEETING APPLIED TO THE ENTIRE BACKGROUND OF THE SIGN. ENCAPSULATED LENS REFLECTIVE SHEETING SHALL BE USED FOR THE SIGN BACKGROUND WHERE NOTED.

TEXT DESIGN
LETTERS, DIGITS, SYMBOLS, SPACINGS, AND TEXT DIMENSIONS SHALL CONFORM WITH THE STANDARD ALPHABETS AND DESIGNS PRESCRIBED IN THE MANUAL ON UNIFORM TRAFFIC CONTROL DEVICES. SEE STANDARD SHEET E-150 FOR ARROWHEAD DETAILS.

SPECIFICATIONS
WARNING SIGNS SHALL MEET THE VERMONT STANDARD SPECIFICATIONS FOR "TRAFFIC SIGNS".

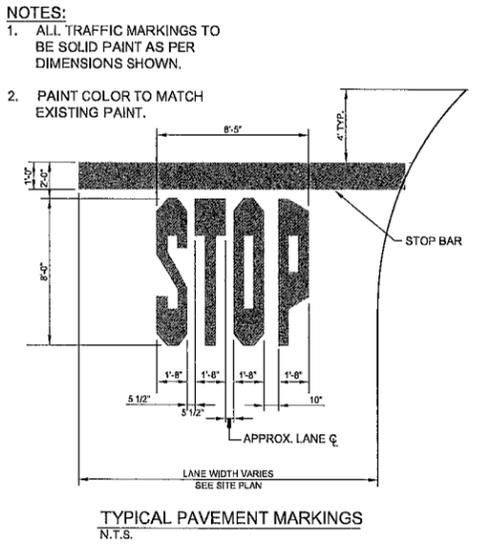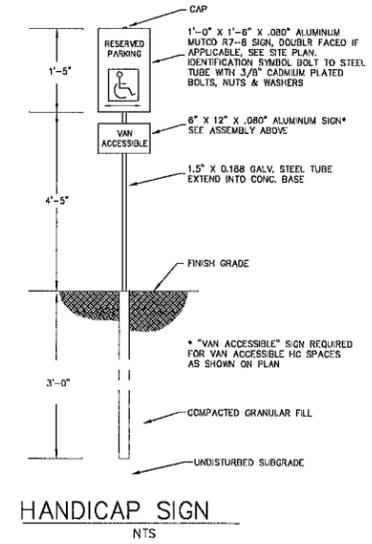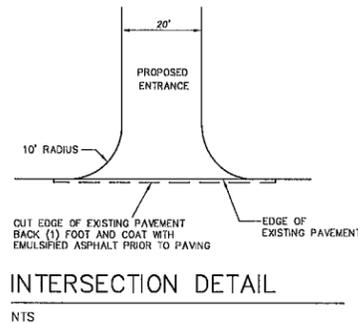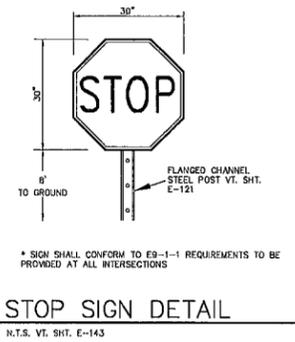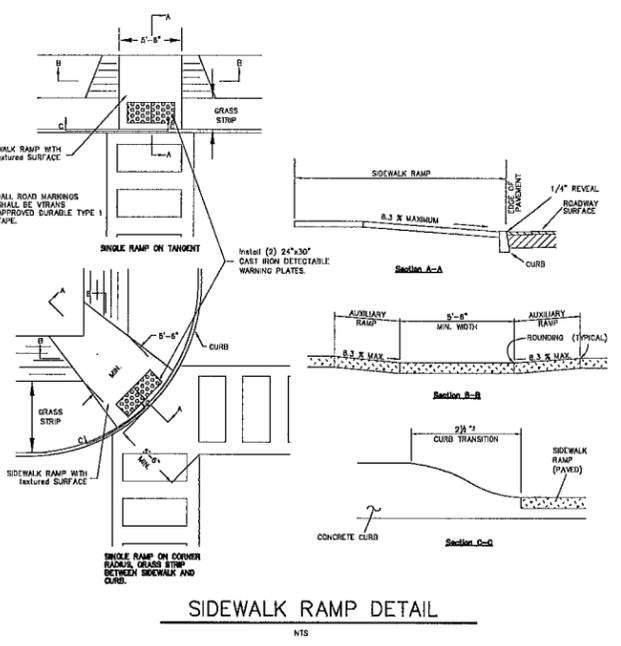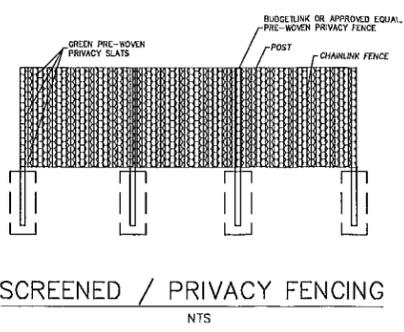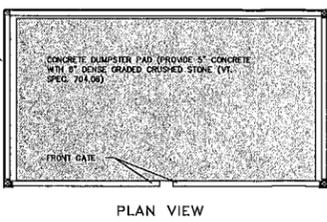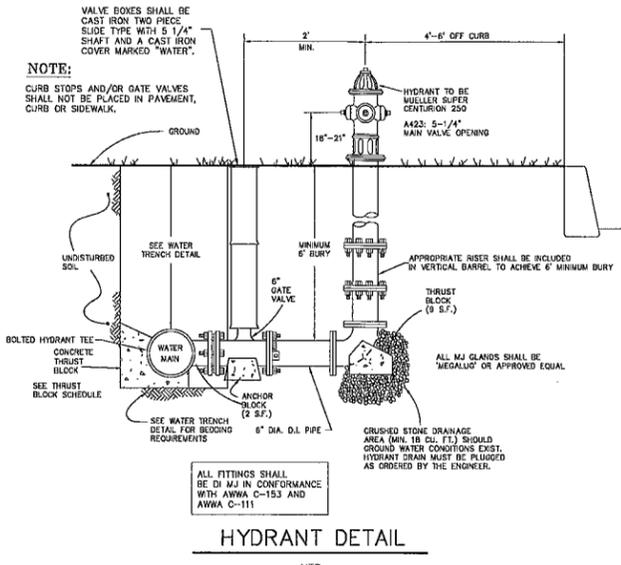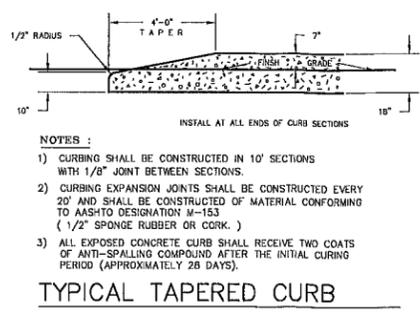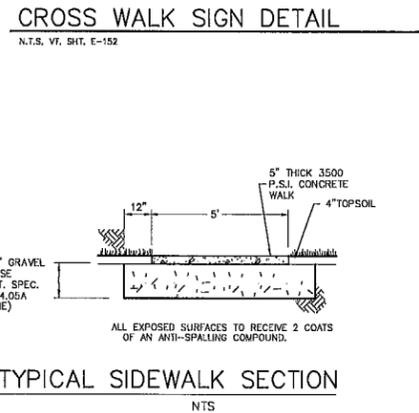

GRADATION REQUIREMENTS		
DENSE GRADED CRUSHED STONE VT SPEC 704.56	3 1/2"	100 %
	3"	90-100%
	2"	75-100%
	1"	50-80%
	1/2"	30-60%
	#4	15-40%
	#200	0-8 %

THE CONTRACTOR SHALL NOTIFY "DIGSAFE" AT 1-888-DIG-SAFE PRIOR TO ANY EXCAVATION.



DATE: 6-1-22
 SURVEY: ODCA
 DESIGN: SEC/OWC
 DRAWN: SEC/OWC
 CHECKED: PLO
 SCALE: 1"=30'

REVISION: REVISION PER IOWAN COMMENTS
 RECORD DRAWING
 PRELIMINARY
 FINAL
 SKETCH/CONCEPT

O'LEARY-BURKE CIVIL ASSOCIATES, PLC
 13 CORPORATE DRIVE
 ESSEX JCT., VT.
 PHONE: 256-8900
 FAX: 878-9380
 E-MAIL: obco@olearyburke.com

Senior Living Facility
Sand Hill Road
 Castleton Vermont


Roadway & General
Construction Details

DATE: 04-09-22
 JOB#: 2021-08
 FILE#: 2021-08-S7
 PLAN SHEET # **9**

Qty	Code	Scientific Name	Common Name	Size	Spec	Notes
15	AD	ABIES balsamea	Balsam Fir	5' Ht.	B&B	
10	ARR	ACER rubrum 'Red Sunset'	Red Sunset Red Maple	2' Cal.	B&B	
5	AF	ACER x freemantli 'Autumn Blaze'	Autumn Blaze Maple	8' Ht.	B&B	Clump Form
10	BNH	BETULA nigra 'Heritage'	Heritage River Birch	10' Ht.	B&B	multi-stemmed
5	BFB	BETULA papyrifera 'Silver'	Paper Birch	8' Ht.	B&B	Clump Form
5	CO	CELTIS occidentalis	Common Hackberry	2' Cal.	B&B	
7	CCI	CRATAEGUS crusgalli inermis	Thornless Cockspur Hawthorn	8' Ht.	B&B	Clump Form
8	GTH	GLEDITSIA 'Halka'	Halka Honeylocust	2' Cal.	B&B	
6	HV	HAMAMELIS virginiana	Common Witchhazel	4' Ht.	B&B	multi-stemmed
7	MLA	LAGERHEDIA villosa 'Ann'	Ann Magnolia	5.6' Ht.	B&B	multi-stemmed
21	PG	PICEA glauca	White Spruce	5' Ht.	B&B	
22	PS	PINUS strobus	White Pine	5' Ht.	B&B	
5	PSA	PRUNUS sargentii	Sargent Cherry	2' Cal.	B&B	
9	QM	QUERCUS macrocarpa	Burn Oak	2' Cal.	B&B	
1	SR	SYRINGA microbotrya 'Ivory Bell'	Japanese Tree Lilac	1.5' Cal.	B&B	
5	TO	THUJA occidentalis 'Nigra'	Dark American Arborvitae	5' Ht.	B&B	
8	TC	TILIA cordata 'Greenspire'	Greenspire Linden	1.5' Cal.	B&B	
11	AV	AZALEA Northern Hi-Lights	Northern Hi-Lights Azalea	24" Ht.	#3 Cont.	
13	CSF	CORNUS sericea 'Floralace'	Floralace Red Dogwood	2' Ht.	#3 Cont.	
23	HPB	HYDRANGEA paniculata 'Bobo'	Bobo Panicle Hydrangea	18" Ht.	#2 Cont.	
10	HPS	HYDRANGEA paniculata 'Sweet Summer'	Sweet Summer Hydrangea	30" Ht.	B&B	
15	JCM	JUNIPERUS chinensis 'Mint Julep'	Mint Julep Juniper	24" Ht.	#3 Cont.	
10	JCS	JUNIPERUS chinensis 'Sea Green'	Sea Green Juniper	30"	B&B	
14	PF	POTENTILLA fruticosa 'Pink Beauty'	Pink Beauty Potentilla	18" Ht.	#3 Cont.	
13	SA	SPIRAEA alba	White Spirea	18"	#3 Cont.	
23	SJ	SPIRAEA japonica 'Little Princess'	Spirea	18"	#3 Cont.	
2	SPJ	Syringa prestoniae 'James MacFarlane'	James MacFarlane Lilac	38" Ht.	#3 Cont.	
10	TMD	TAXUS media 'Tremuloides'	Bessew Wax	16" Ht.	B&B	
18	AG	ANDROPOGON gerardi 'Red October'	Red October Big Bluestem	Clump	#2 Cont.	
9	ACP	ASTILBE chinensis 'Pumila'	Pumila Astilbe	Clump	#1 Cont.	
24	AF	ATHYRIUM 'Lady in Red'	Northern Lady Fern	Clump	#1 Cont.	
18	CB	CALAMAGROSTIS trachyocha	Korean Feather Reed Grass	Clump	#1 Cont.	
25	CK	CALAMAGROSTIS 'Karl Foerster'	Feather Reed Grass	Clump	#1 Cont.	
20	EPR	ECHINACEA 'Rainbow Marcella'	Rainbow Marcella Echinacea	Clump	#2 Cont.	
17	HHR	HEMEROCALLIS 'Rosy Returns'	Rosy Returns Day Lily	Clump	#2 Cont.	30" O.C.
14	HD	HEMEROCALLIS 'Stella Dorada'	Rosy Returns Day Lily	Clump	#2 Cont.	30" O.C.
63	RAG	RHUS aromatica 'Goldstorm'	Gold-stem Fragrant Sumac	18" Ht.	#3 Cont.	
12	RFG	RUDBECKIA hirta var. s. 'Goldsturm'	Black Eye Susan	Clump	#2 Cont.	

LEGEND

- DECIDUOUS SHADE TREE
- DECIDUOUS SMALL TREE
- CONIFER LARGE TREE
- CONIFER SMALL TREE
- DECIDUOUS SHRUB
- CONIFER SHRUB
- PERENNIAL GROUNDCOVER
- EXISTING TREE TO REMAIN

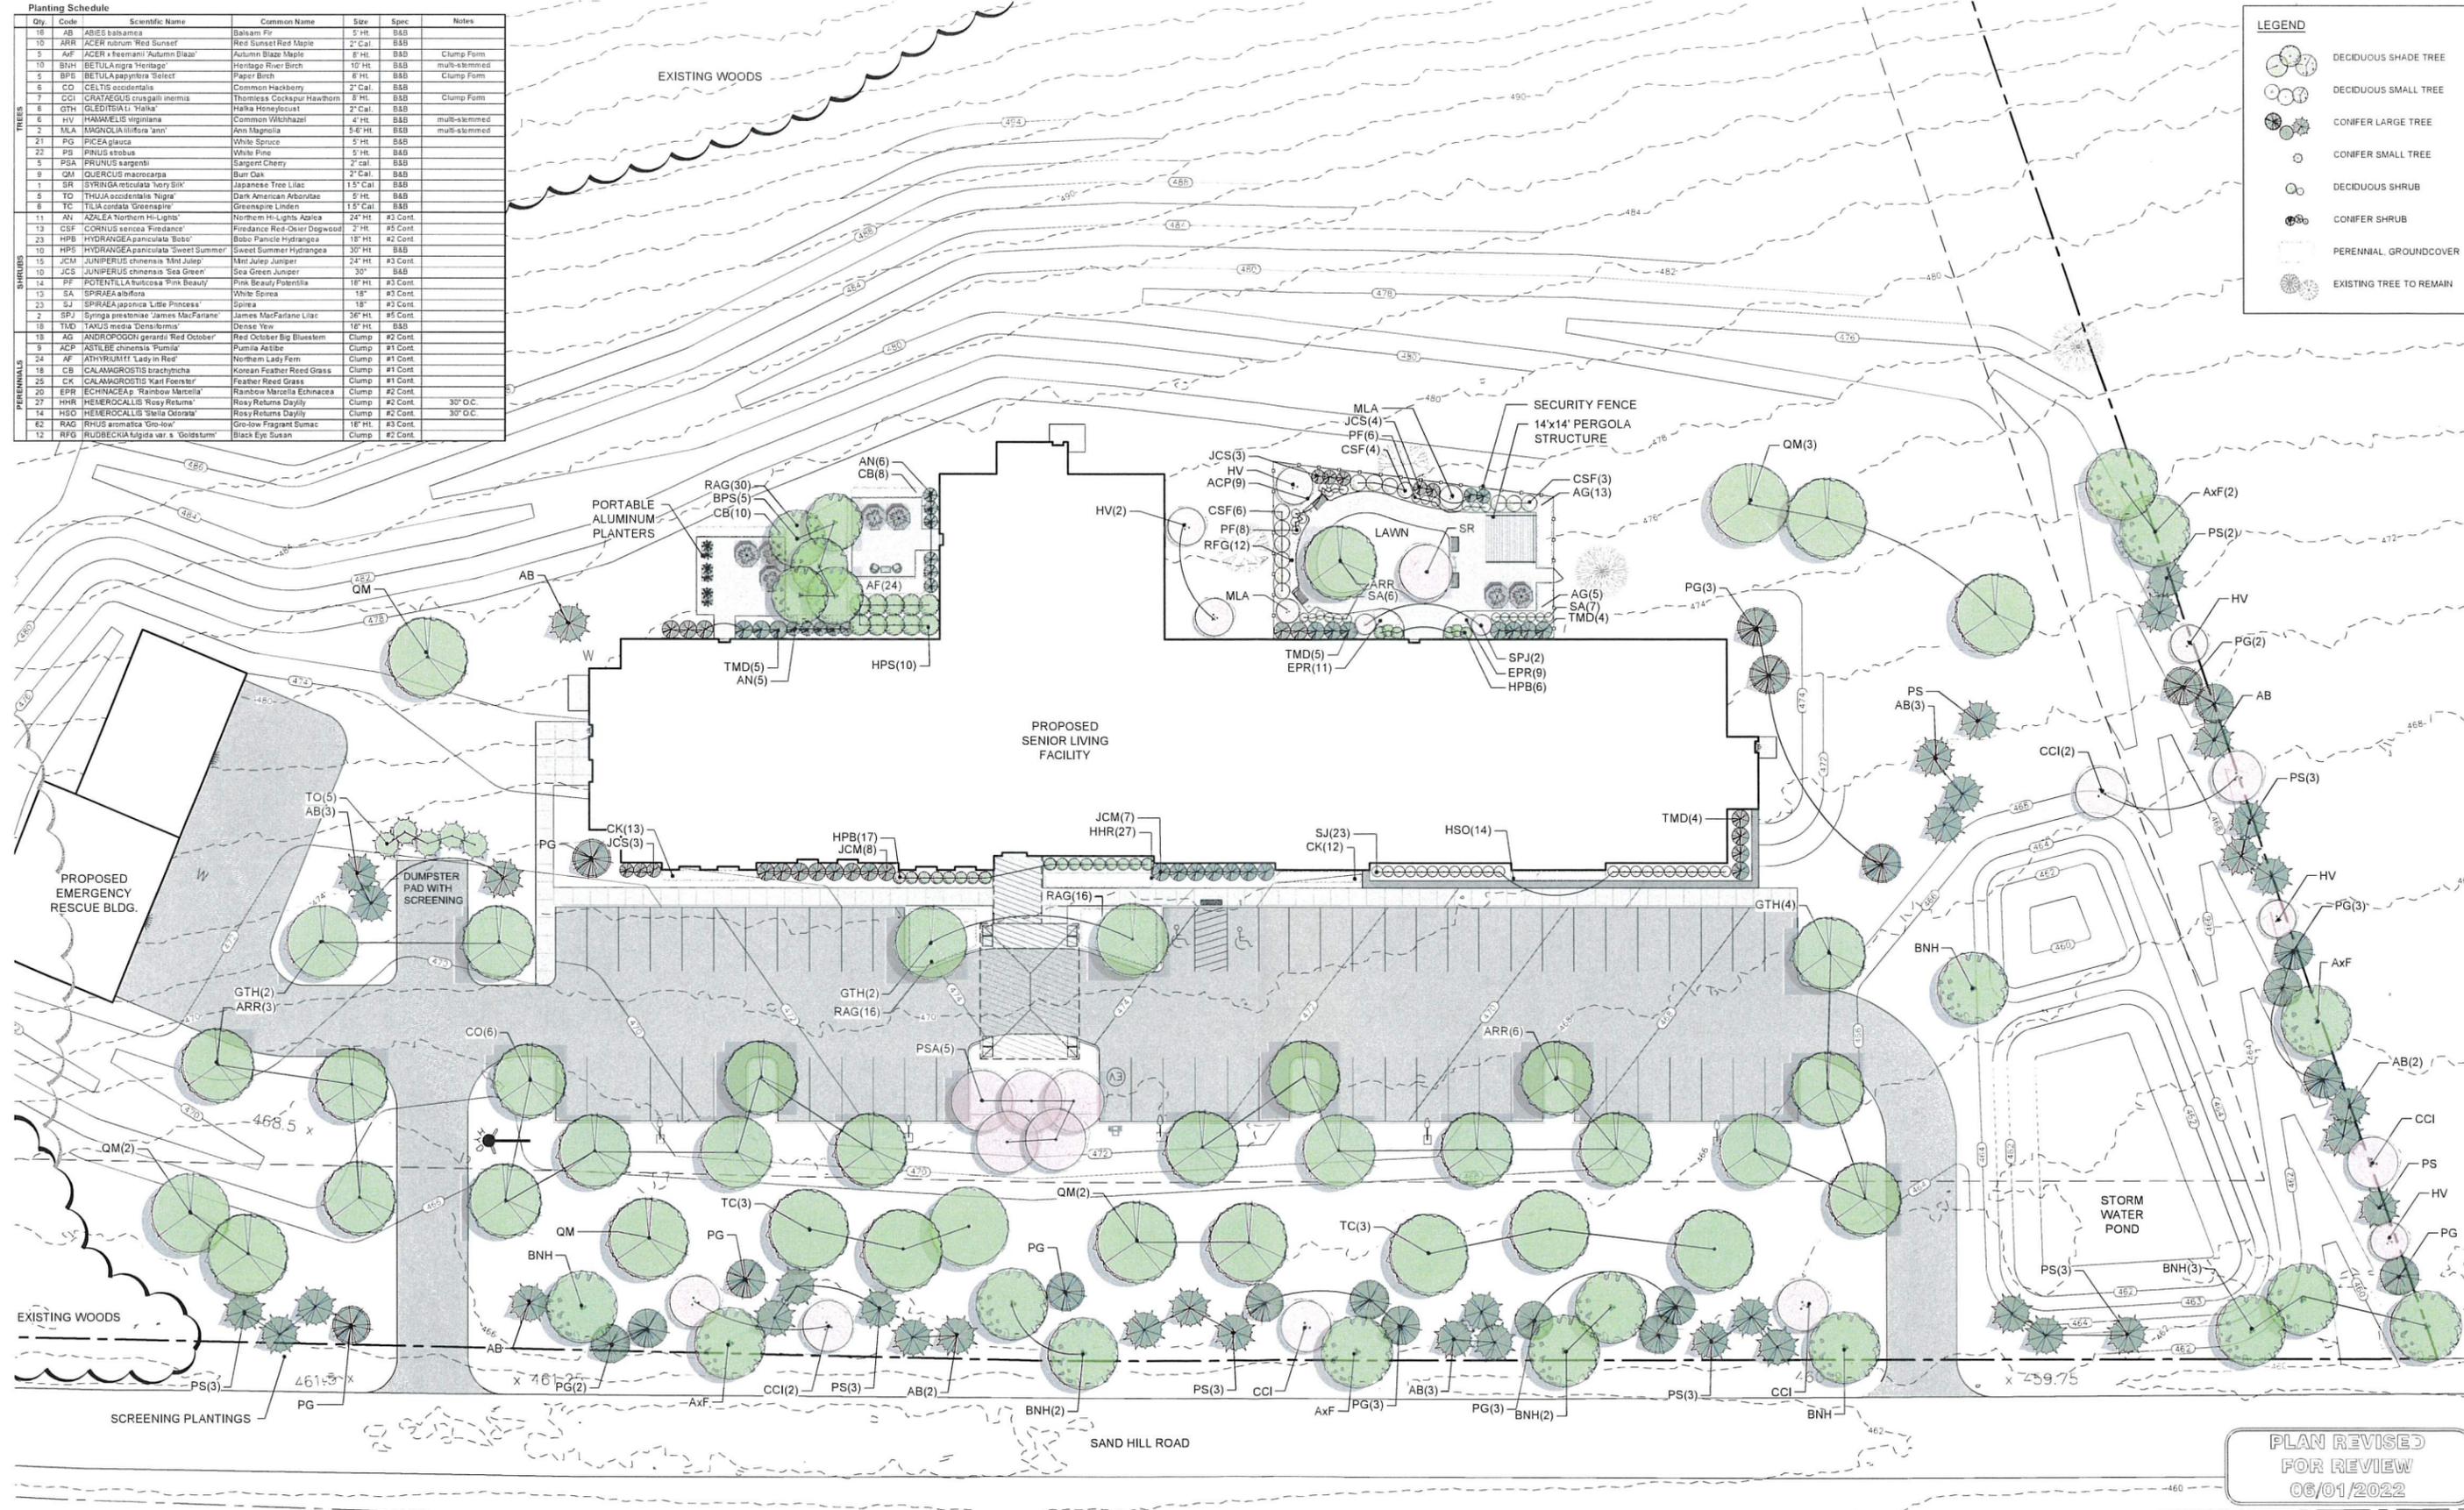


PLAN REVISED
FOR REVIEW
06/01/2022



TREE PRUNING NOTES

- REFER TO ANSI A300 (Part 1, MOST UPDATED VERSION) PRUNING SPECIFICATIONS FOR ADDITIONAL INFORMATION.
- WORK SHOULD BE PERFORMED BY A CERTIFIED ARBORIST OR PROFESSIONAL TREE COMPANY.
- AVOID DAMAGING BARK AND OTHER LIVING TISSUE THROUGHOUT THE PRUNING PROCESS.
- MAKE SURE PRUNING TOOLS ARE SHARP.
- MAKE CLEAN CUT AS CLOSE TO THE BRANCH COLLAR AS POSSIBLE. DO NOT LEAVE A STUB.
- REDUCE THE SIZE OF THE BRANCH FOR A BETTER CUT.
- THE FIRST AND SECOND CUTS SHOULD BISECT THE ANGLE BETWEEN ITS BRANCH BARK RIDGE AND AN IMAGINARY LINE PERPENDICULAR TO THE BRANCH OR STEM.
- NOT MORE THAN 25% OF GROWTH SHOULD BE REMOVED FROM A CANOPY DURING A GROWING SEASON.

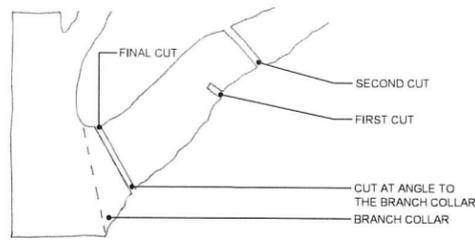


10 TREE PRUNING ILLUSTRATION
L2.0 NTS


TREE PROTECTION NOTES

- PRIOR TO ANY CONSTRUCTION ACTIVITY, ALL TREE PRESERVATION MEASURES MUST BE IMPLEMENTED.
- CONTRACTOR CHOSEN FOR THIS WORK WILL BE AN EXPERIENCED TREE SERVICE FIRM THAT HAS SUCCESSFULLY COMPLETED TREE PROTECTION, ROOT PRUNING, AND TRIMMING WORK, SIMILAR TO THAT REQUIRED FOR THIS PROJECT.
- PRIOR TO CONSTRUCTION SHALL LOCATE AND VERIFY THE EXISTENCE OF ALL UTILITIES PRIOR TO STARTING WORK. CONTACT DIG SAFE TWO FULL BUSINESS DAYS BEFORE PLANTING. (48 HOUR MIN.)
- PRIOR TO THE SITE VISIT ALL TREE PRESERVATION AREAS SHALL BE STAKED OUT ON SITE BY SURVEY.
- TREE PROTECTION FENCING SHALL REMAIN INTACT THROUGHOUT ALL CONSTRUCTION ACTIVITY.
- THERE WILL BE NO EXCAVATION FOR PROPOSED SITE WORK WITHIN FENCED AREA.
- NO MATERIALS OR EQUIPMENT SHALL BE STORED, STOCKPILED OR OPERATED WITHIN TREE PROTECTION AREAS.
- TREE PROTECTED AREAS WILL BE LEFT AS NATURAL AS POSSIBLE.
- IN AREAS OF EXCAVATION NEAR TREE, IDENTIFY AND CUT ROOTS IN CONSULTATION WITH OWNER.
- REMOVE POORLY ATTACHED AND RUBBING LIMBS. CLEAN THE CROWN OF DEAD, DISEASED AND WEAK LIMBS. THINNING OF HEALTHY LIMBS IS NOT RECOMMENDED AT THIS TIME.
- ANY NECESSARY TRENCHING SHALL BE IMMEDIATELY BACKFILLED WITH REMOVED SOIL OR OTHER SOIL MIX AS DESCRIBED IN CONTRACT SPECIFICATIONS.
- AN AIR SPADE/AIR KNIFE IS TO BE USED TO EXCAVATE DOWN TO MINIMUM OF 2'. SEE DETAILS.


- SIGN DETAIL**
- ATTACHMENTS OF SIGNS TO TREES IS PROHIBITED.
 - SIGNS SHOULD BE MADE OF VINYL OR PLASTIC.
 - SIGNS SHOULD BE PROPERLY MAINTAINED, PENALTIES WILL BE ENFORCED FOR REMOVAL OF SIGNS.
 - AVOID INJURY TO ROOTS WHEN PLACING POSTS FOR THE SIGNS.
 - SIGNS SHOULD BE POSTED 50' O.C. AND WITHIN 20' OF THE BEGINNING AND END OF EACH FENCE TO BE VISIBLE TO ALL CONSTRUCTION PERSONNEL.
 - SIGNS TO BE SECURELY FASTENED TO THE FENCE OR FENCE POSTS.
 - SIGNS TO HAVE A WHITE BACKGROUND AND ORANGE OR RED TEXT.

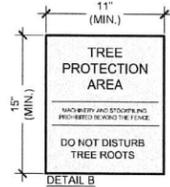

- FENCE DETAIL**
- THIS FENCE SERVES AS A TREE PROTECTION DEVICE ONLY.
 - ROOT DAMAGE SHALL BE AVOIDED WITHIN FENCED AREA.
 - FENCE SHALL BE MAINTAINED THROUGHOUT CONSTRUCTION.

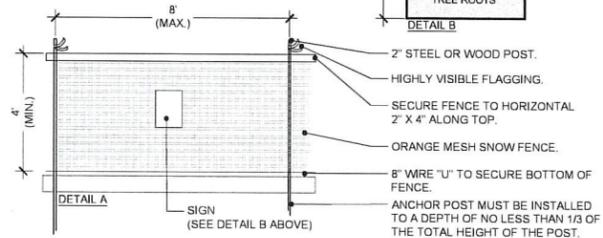


9 TREE PROTECTION FENCE
L2.0 NTS

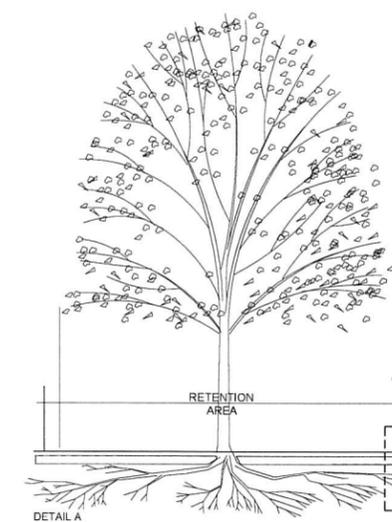

8 TREE PROTECTION
L2.0 NTS

ROOT PRUNING TRENCH NOTES

- USE AN AIR SPADE/AIR KNIFE TO DIG THE 2' TRENCH AND EXPOSE THE ROOTS.
- EXPOSED ROOTS SHOULD BE CUT WITH A SAW OR LOPPERS TO MAKE A CLEAN SMOOTH CUT, NOT TORN OR RIPPED.
- MULCH EXPOSED ROOTS DURING THE CUTTING PROCESS TO KEEP FROM DRYING OUT.
- BACKFILL TRENCH WITH MIXTURE OF TOPSOIL AND COMPOST AS PER CONTRACT SPECIFICATIONS.

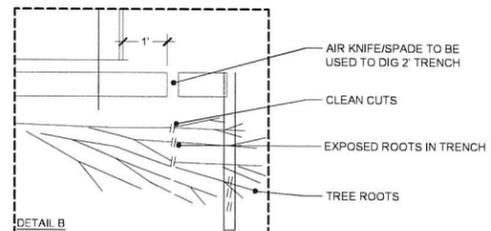

- DRIP LINE OF TREE
- TREE PROTECTION FENCE PLACED AT EDGE OF SIDEWALK, CURB, OR 1' BEYOND DRIP LINE OR FURTHER, IF POSSIBLE.
- ROOT PRUNING TRENCH (MIN. 2' DEPTH). SEE BLOW UP TRENCH DETAIL B ABOVE.


GENERAL PLANTING NOTES

- THE LANDSCAPE CONTRACTOR SHALL LOCATE AND VERIFY THE EXISTENCE OF ALL UTILITIES PRIOR TO STARTING WORK. CONTACT DIG SAFE TWO FULL BUSINESS DAYS BEFORE PLANTING. (48 HOUR MIN.)
- THE LANDSCAPE CONTRACTOR SHALL SUPPLY ALL PLANT MATERIAL IN QUANTITIES SUFFICIENT TO COMPLETE THE PLANTING SHOWN ON ALL DRAWINGS. THE PLANT QUANTITIES SHALL ALWAYS SUPERCEDE THE PLANT LIST.
- ALL PLANT MATERIAL SHALL CONFORM AND BE INSTALLED TO THE GUIDELINES ESTABLISHED BY THE CURRENT ANSI Z60.1.
- NO PLANT SHALL BE PUT INTO THE GROUND BEFORE ROUGH GRADING HAS BEEN FINISHED AND APPROVED BY THE PROJECT LANDSCAPE ARCHITECT OR EQUAL.
- THE LANDSCAPE CONTRACTOR SHALL PROVIDE AMENDED PLANTING SOIL AS PER THE CONTRACT SPECIFICATIONS.
- SOIL DEPTH SHOULD BE AS LISTED BELOW. EXISTING SOIL ON SITE WHICH MEETS THE CONTRACT SPECIFICATIONS MAY BE USED. REMOVE SUB GRADE AND OTHER GRAVEL FILL IN PLANTING AREAS ON SITE.
 - 7.1. GROUND COVER BEDS: 12" DEPTH.
 - 7.2. LAWN AREAS: 6" DEPTH
 - 7.3. SHRUB/PLANT BEDS: 18" DEPTH
- PLANTS SHALL BE INSTALLED SUCH THAT THE ROOT FLARE IS AT OR SLIGHTLY ABOVE FINAL GRADE (DUE TO NURSERY PRACTICES THIS MAY REQUIRE REMOVING SOIL FROM THE TOP OF THE ROOT BALL TO LOCATE THE ROOT FLARE).
- ALL PLANTS SHALL BE BALLED AND BURLAPPED OR CONTAINER GROWN AS SPECIFIED. NO CONTAINER GROWN STOCK WILL BE ACCEPTED IF IT IS ROOT BOUND. ALL ROOT WRAPPING MATERIAL MADE OF SYNTHETICS OR PLASTICS SHALL BE REMOVED AT THE TIME OF PLANTING.
- WITH CONTAINER GROWN STOCK, THE CONTAINER SHALL BE REMOVED AND THE CONTAINER BALL SHALL BE CUT THROUGH THE SURFACE IN TWO VERTICAL LOCATIONS.
- THE DAY PRIOR TO PLANTING, THE LOCATION OF ALL TREES AND SHRUBS SHALL BE FLAGGED FOR APPROVAL BY THE PROJECT LANDSCAPE ARCHITECT OR EQUAL.
- LANDSCAPE ARCHITECT MAY REQUIRE ALL PLANTS BE SPRAYED WITH AN ANTIDESSICANT WITHIN 24 HOURS AFTER PLANTING. IN TEMPERATE ZONES, ALL PLANTS SHALL BE SPRAYED WITH AN ANTIDESSICANT AT THE BEGINNING OF THEIR FIRST WINTER.
- STAKING PLANTS IS AT THE DISCRETION OF THE LANDSCAPE CONTRACTOR. ONLY STAKE PLANTS IN THE MANNER SPECIFIED IN THE PLANTING DETAILS.
- ALL PLANTS SHALL BE WATERED THOROUGHLY TWICE DURING THE FIRST 24 HOUR PERIOD AFTER PLANTING. ALL PLANTS SHALL THEN BE WATERED WEEKLY, IF NECESSARY, DURING THE FIRST GROWING SEASON.
- THE LANDSCAPE CONTRACTOR SHALL REFER TO THE CONTRACT SPECIFICATIONS FOR ADDITIONAL REQUIREMENTS.
- THE LANDSCAPE CONTRACTOR SHALL REFER TO THE PLANT LIST FOR SEASONAL REQUIREMENTS RELATED TO THE TIME OF PLANTING.

PLANT SPACING CHART


Spacing 'O'	Row 'A'	Number of Plants	Area Unit
6' O.C.	5.2'	4.61	1 SQ. FT.
8' O.C.	6.93'	2.6	
10' O.C.	8.66'	1.66	
12' O.C.	10.4'	1.15	10 SQ. FT.
15' O.C.	13.0'	7.38	
18' O.C.	15.6'	5.12	
24' O.C.	20.8'	2.91	
30' O.C.	26.0'	1.55	
36' O.C.	30.0'	1.25	100 SQ. FT.
4' O.C.	3.46'	7.25	
5' O.C.	4.38'	4.61	
6' O.C.	5.2'	3.2	
8' O.C.	6.93'	1.8	
10' O.C.	8.66'	1.16	
12' O.C.	10.4'	8	1000 SQ. FT.
15' O.C.	13.0'	5	
20' O.C.	17.3'	2.88	
25' O.C.	21.65'	1.85	
30' O.C.	26.0'	1.29	
40' O.C.	34.6'	7.22	

O.C. = ON CENTER FOR USE WHEN PLANTS ARE SHOWN EQUIDISTANT FROM EACH OTHER (AS SHOWN) PLANT SPACING CHART

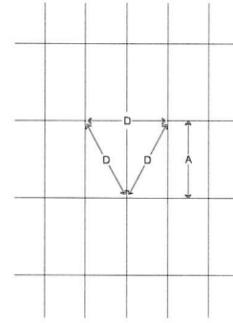


7 PLANT SPACING CHART DETAIL
L2.0 NTS

- SOIL COMPACTION AFTER INSTALLATION SHALL BE 75-250 PSI AT SOIL MOISTURE BETWEEN FIELD CAPACITY AND WILTING POINT

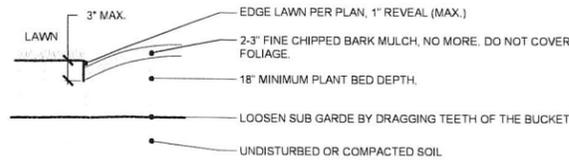


6 PLANT BED
L2.0 NTS


- SOIL COMPACTION AFTER INSTALLATION SHALL BE 75-250 PSI AT SOIL MOISTURE BETWEEN FIELD CAPACITY AND WILTING POINT

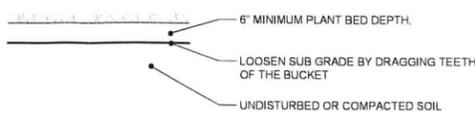


5 LAWN & SEEDING AREA
L2.0 NTS

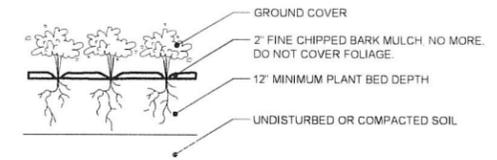

4 GROUNDCOVER PLANTING
L2.0 NTS

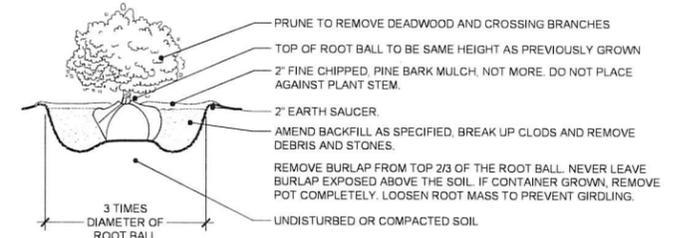


3 SHRUB PLANTING
L2.0 NTS

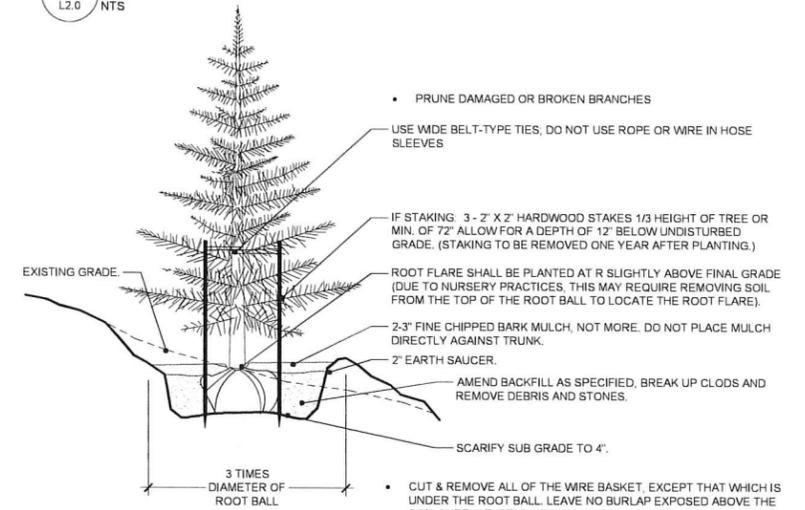

2 TREE PLANTING ON SLOPE DETAIL
L2.0 NTS

- PRUNE DAMAGED OR BROKEN BRANCHES
- USE WIDE BELT-TYPE TIES, DO NOT USE ROPE OR WIRE IN HOSE SLEEVES
- REUSABLE PERFORATED PLASTIC TREE WRAP (TO BE REMOVED ONE YEAR AFTER PLANTING). USE IF NECESSARY.
- 3 - 2\"/>

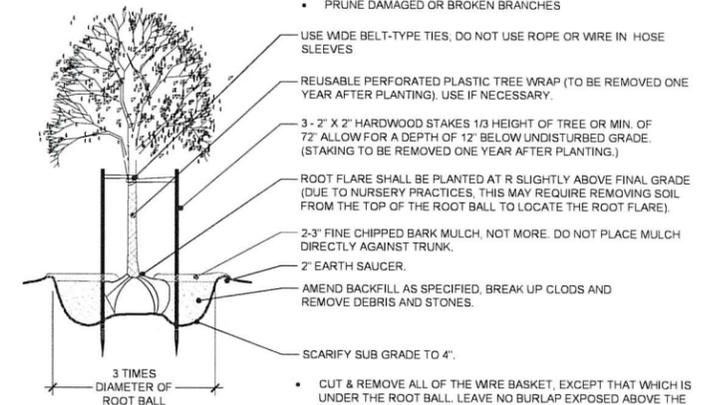

1 TREE PLANTING DETAIL
L2.0 NTS